

LAND CORNER RECORDATION CERTIFICATE  
Filing Requirement of Act 74, Mich. P.A. 1970

SURVEY &  
DESCRIPTION

Nov. 6, 1998  
Robert W. Crampton

For corners in  
HOUGHTON  
(County)

Located In:

Corner Code #

DEC 14 1998

SECTION

1. Public Land Survey T 53W R 33W  
T 53W R 33W  
T \_\_\_\_\_ R \_\_\_\_\_  
T \_\_\_\_\_ R \_\_\_\_\_  
2. Property Controlling S \_\_\_\_\_ T \_\_\_\_\_ R \_\_\_\_\_  
in Section S \_\_\_\_\_ T \_\_\_\_\_ R \_\_\_\_\_  
3. Miscellaneous S \_\_\_\_\_ T \_\_\_\_\_ R \_\_\_\_\_  
Property in Section S \_\_\_\_\_ T \_\_\_\_\_ R \_\_\_\_\_

K-7  
MEANDER-19

Seg. 1

ROBERT F. MIKESCH 11/16/98  
HOUGHTON COUNTY, REGISTER 14:45  
LC 3/ 546 PAU Fee: 9.00  
Page 1 of 1 mber

4. Lot No. \_\_\_\_\_, Recorded Plat \_\_\_\_\_  
5. Private Claims \_\_\_\_\_

I, R. W. CRAMPTON, in a field survey on OCTOBER 23, 1998,  
do hereby certify that under requirements of P.A. 74, Michigan P.A. of 1970, the corner points mentioned  
in lines 1 and 2 above were in conformance with regulations and rules therefore as required in the current  
manual of survey instructions of the United States Department of the Interior, Bureau of Land  
Management or by a decree of a Court of Law and/or that the corner points mentioned in lines 3, 4 and  
5 above were in conformance with the rules of the Michigan Board of Professional Surveyors or by a  
Decree of a Court of Law; established, re-established, monumented, re-monumented, recovered, found  
as expressed below:

NOTE: Not more than 4 corners, all in the same town and range, may be recorded  
on this certificate.

A. Description of original monument and accessories and/or subsequent restoration:

K-7, SECTION CORNER COMMON TO SECTIONS 13, 14, 23 AND 24.  
SET POST, FIR 7 N64W 30, Y. BIRCH 7, S40E 8.

MEANDER-19, TAMARACK 10 FOR MEANDER CORNER, SPRUCE 10, S45W 06.

B. Description of corner evidence found and/or method applied in restoring or reestablishing corner:


K-7, FOUND 1/2" CAPPED IRON ROD, FROM RECORDED CORNER LIBER 1, PAGE 673, NOV. 19, 1981.  
BY U.P. ENGINEERS & ARCHITECTS, INC. DATED 10/26/95.

MEANDER-19, FOUND 3/4" IRON PIPE IN CONCRETE 0.23' NORTH OF LINE BETWEEN SW CORNER  
AND SE CORNER OF SECTION 13, T53N, R33W.

C. Description of monument for corner and accessories established to perpetuate locating the position of the corner:

K-7 REPLACED WITH 1" IRON PIPE WITH 2 1/4" BRASS CAP, WITNESSES:  
7" CEDAR TREE S32°E 42.48', 7" POPLAR TREE N34°W 55.39',  
6" BALSAM TREE N19°E 39.87', 9" POPLAR TREE N35°E 46.88'.

MEANDER-19 LEFT 3/4" IRON PIPE IN CONCRETE AND CAPPED WITH 2 1/4" BRASS CAP, WITNESSED WITH  
SURVEY TAG NAILED TO: 24" W. PINE TREE N60°W 57.88', N13°W 32.70' TO SW CORNER LOG  
BOAT HOUSES, S22°W 63.87' TO NE CORNER FRAMED GARAGE, S41°W 76.94' TO NW CORNER  
FRAMED GARAGE

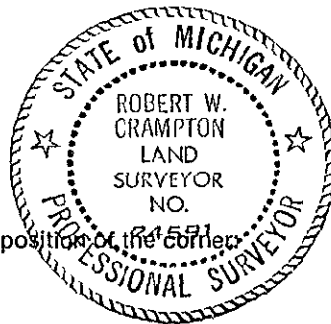

Signed by Robert W. Crampton Date Nov. 4, 1998  
Surveyor's Michigan License No. 24591