

Robert W. Crampton  
9/14/99

LAND CORNER RECORDATION CERTIFICATE  
Filing Requirement of Act 74, Mich. P.A. 1970

RECORDED

JAN 25 2000

SECTION

For corners in  
HOUGHTON  
(County)

Located In:

Corner Code #

MARY SCHOOS 09/27/99  
HOUGHTON COUNTY, REGISTER 10:10  
LC 4/ 27 PAU Fee: 9.00  
Page 1 of 1

1. Public Land Survey

T 53N R 32W  
T 53N R 33W  
T \_\_\_\_\_ R \_\_\_\_\_  
T \_\_\_\_\_ R \_\_\_\_\_

8 (A-5/6)  
26 (M-5/6) ✓  
9 (A/B-5)

2. Property Controlling  
in Section

S \_\_\_\_\_ T \_\_\_\_\_ R \_\_\_\_\_  
S \_\_\_\_\_ T \_\_\_\_\_ R \_\_\_\_\_

3. Miscellaneous

S \_\_\_\_\_ T \_\_\_\_\_ R \_\_\_\_\_

Property in Section

S \_\_\_\_\_ T \_\_\_\_\_ R \_\_\_\_\_

Register of Deeds Stamp & File Number

4. Lot No. \_\_\_\_\_, Recorded Plat \_\_\_\_\_

5. Private Claims \_\_\_\_\_

I, R.W. CRAMPTON, in a field survey on JUNE 17, 19 99,  
do hereby certify that under requirements of P.A. 74, Michigan P.A. of 1970, the corner points mentioned  
in lines 1 and 2 above were in conformance with regulations and rules therefore as required in the current  
manual of survey instructions of the United States Department of the Interior, Bureau of Land  
Management or by a decree of a Court of Law and/or that the corner points mentioned in lines 3, 4 and  
5 above were in conformance with the rules of the Michigan Board of Professional Surveyors or by a  
Decree of a Court of Law; established, re-established, monumented, re-monumented, recovered, found  
as expressed below:

NOTE: Not more than 4 corners, all in the same town and range, may be recorded  
on this certificate.

A. Description of original monument and accessories and/or subsequent restoration:

8, NOT SET IN ORIG. SURVEY.

9, NOT SET IN ORIG. SURVEY.

B. Description of corner evidence found and/or method applied in restoring or reestablishing corner:

8, 3/4" IRON PIPE SET, REPLACED WITH 1" IRON PIPE WITH BRASS CAP, ON MEANDER LINE OF  
UNRECORDED PLAT OF PORTAGE VIEW LOTS, IN LOT 21 AND ON WEST LINE OF SECTION 18.


9, CONCRETE MONUMENT FOUND ON NORTH SECTION LINE & NORTH LINE OF THE  
UNRECORDED PLAT OF PORTAGE VIEW LOTS AS PER PLAT.

C. Description of monument for corner and accessories established to perpetuate locating the position of the corner:

8, THE 1" IRON PIPE WITH BRASS CAP WAS WITNESSED WITH SURVEY TAG NAILED TO:  
6" BALSAM TREE N50°W 16.09', 14" W. BIRCH TREE S15°E 28.30',  
S36°W 38.08' TO CONCRETE MONUMENT, N36°E 35.07' TO 1 1/4" IRON PIPE.

9, THE CONCRETE MONUMENT WAS WITNESSED WITH SURVEY TAG NAILED TO:  
4" TAMARACK TREE S70°E 16.20', 16" Y. BIRCH S31°E 33.29',  
S66°W 12.44' TO 1 1/4" IRON PIPE, EAST 74.77' TO 1 1/4" IRON PIPE.

	A	B	C	D	E	F	G	H	I	J	K	L	M
2	6		5		4		3		2		1		
3													
4	7		6		9		10		11		12		
5													
6	18		17		16		15		14		13		
7													
8	19		20		21		22		23		24		
9													
10	30		29		28		27		26		25		
11													
12	31		32		33		34		35		36		
13													

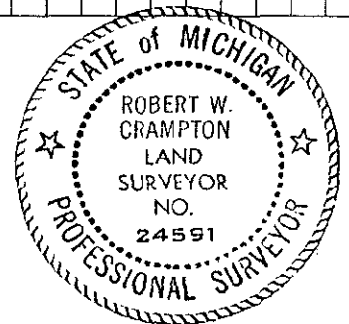

Signed by Robert W. Crampton

Date SEPT. 23, 1999

Surveyor's Michigan License No. 24591