

LAND CORNER RECORDATION CERTIFICATE
Filing Requirement of Act 74, Mich. P.A. 1970 as Amended

For corners in

| Houghton (County) | Located In: | Corner Code # |
|---------------------------------------|---|------------------|
| 1. Public Land Survey | T _____ R _____ T _____ R _____ T _____ R _____ | _____ |
| 2. Property Controlling in Section | S 30 T 55N R 32W S 30 T 55N R 32W S _____ T _____ R _____ | 5 SMC E of #5 |
| 3. Miscellaneous Property in Sec. | S _____ T _____ R _____ S _____ T _____ R _____ | _____ |
| 4. Lot No. _____, Recorded Plat _____ | | |
| 5. Private Claims _____ | | |

I, Stephan J. Szyszkoski, in a field survey on 5 07/28/2011 do hereby state
that under requirements of P.A. 74, Michigan P.A. of 1970, the corner points mentioned in lines 1 and 2
above were in conformance with regulations and rules therefore as required in the current manual of survey
instructions of the United States Department of the Interior, Bureau of Land Management or by a decree of
a Court of Law and /or that the corner points mentioned in lines 3, 4 and 5 above were in conformance with
the rules of the Michigan Board of Land Surveyors or by a Decree of a Court of Law; established,
re-established, monumented, recovered, found as expressed below:

NOTE: Not more than 2 corners, all in the same town and range, may be recorded
on this certificate.

A. Description of original monument and accessories and/or subsequent restoration:

(5-Sec. 30) North 1/16 corner, Section 30. Not previously established.

(SMC East of 1/16 corner #5, Section 30) Special Meander Corner at the intersection of the North 1/16
line of Section 30 with the edge of the leatherleaf and tag alder marsh on the west side of Portage
Lake. Not established in the original survey.

B. Description of corner evidence found and/or method applied in restoring or reestablishing corner:

(5-Sec. 30) Established the corner midway and on a straight line between the Center of Section 30
1290.06' south and Quarter corner B9 1290.06' north.

(SMC) Established the corner on the North 1/16 line, having a bearing which is the mean of the north
line of Section 30 and the E-W 1/4 line of Section 30, 1186.46' east of the monumented 1/16 corner
#5, Section 30. The position for the corner falls at the transition from lowland Cedar, Maple and
Balsam, to a leatherleaf and alder marsh.

C. Description of monument for corner and accessories established to perpetuate locating the position of the corner:


(5) Set 1"IDx32" I.pipe with 4" alum. MDNR cap.
Set measuring nail with MDNR tag in the side of:
7" Box Elder N26W 5.4' mrkd "1/16S BT"
6" Maple N84E 21.00' do
6" B.Ash S04E 3.9' do
9" Box Elder S84W 5.85' do
Set sq'd cedar post adjacent.
Bearings are magnetic.

(SMC) Set 1"IDx32" I.pipe with 4" alum. MDNR cap.
Set measuring nail with MDNR tag in the side of:
7" Cedar N58E 13.0' mrkd "SMC BT"
9" Maple S59E 3.3' do
3" Cedar S43W 10.7' do
3" Cedar N26W 7.7' do
Set sq'd cedar post adjacent.
Bearings are magnetic.

Signed by Stephan J. Szyszkoski
Surveyor's Michigan License No. 33986

Date 11/17/2011

For the Michigan Department of Natural Resources, Forest Management Division

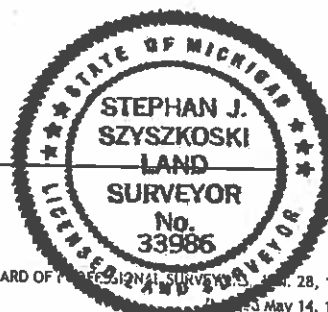

16778

16777