

SURVEY &
REMONUMENTATION

MAR 19 1997

1996

REMONUMENTATION

Re-Mon Liber 1, Page 54

COMMISSION

LAND CORNER RECORDATION CERTIFICATE
Filing Requirement of Act 74, Mich. P.A. 1970

For corners in Bingham Township

Huron County
(County)

Located in:

Corner Code #

1. Public Land Survey

T15N R13E

A-13

T15N R12E

M-13

T14N R13E

A-01

T14N R12E

M-01

2. Property Controlling
in Section

S T R

S T R

3. Miscellaneous
Property in Sec.

S T R

S T R

STATE OF MICHIGAN
HURON COUNTY
RECORDED

7 NOV 96 4:08 P.M.

FRANCES L. HOLWICK
REGISTER OF DEEDS

Register of Deeds Stamp & File Number

4. Lot No. , Recorded Plat

5. Private Claims

I, Russell L. Brown, in a field survey on Oct. 8, 19 96 do hereby state that under requirements of P.A. 74, Michigan P.A. of 1970, the corner points mentioned in lines 1 and 2 above were in conformance with regulations and rules therefore as required in the current manual of survey instructions of the United States Department of the Interior, Bureau of Land Management or by a decree of a Court of Law and/or that the corner points mentioned in lines 3, 4 and 5 above were in conformance with the rules of the Michigan Board of Land Surveyors or by a Decree of a Court of Law; established, re-established, monumented, recovered, found as expressed below:

NOTE: Not more than 2 corners, all in the same town and range, may be recorded on this certificate.

	A	B	C	D	E	F	G	H	I	J	K	L	M
1													
2	6			5			4			3		2	1
3													
4	7			8			9			10		11	12
5													
6	18			17			16			15		14	13
7													
8	19			20			21			22		23	24
9													
10	30			29			28			27		26	25
11													
12	31			32			33			34		35	36

A. Description of original monument and accessories and/or subsequent restoration:

1834 G.L.O., H. Parke D.S.
Township Corner Post
Lynn 24", N88 1/2E 52 Links
Beech, S67W 33 Links

County Surveyor Records:
NONE

(OVER)

County Road Commission Records:

1/2" Iron Pipe, replaced with 3/4" Iron Pin
Spike in Power Pole, N55°E 63.85'
Spike in Telephone Pole, S45°E 70.85'
Spike in Telephone Pole, N45°W 52.30'

B. Description of corner evidence found and/or method applied in restoring or reestablishing corner:

Found 1" Pipe in Monument Box, centerline Asphalt Road North and South, centerline gravel road West and 6'± North centerline gravel road East.

Accepted: Found 1" Pipe in Monument Box as the best evidence of the original position of Corner A-13.

Description of monument for corner and accessories established to perpetuate locating the position of the corner:
S.W. Corner Section 31, T15N-R13E A-13

Found 1" Pipe in Monument Box

WITNESSES:

N45°W 57.69' to 1/2" Dia. Steel Stake capped RLS 24588

S45°W 72.90' Found Form Nail and Flasher on Northwest Side of Power Pole


S30°E 62.63' to 1/2" Dia. Steel Stake capped RLS 24588

N45°E 63.93' Found P.K. Nail in Northwest Side Power Pole

NOTE: This corner is common with M-13, T15N-R12E, M-1, T14N-R12E, and A-1, T14N-R13E

Surveyed by Russell L. Brown
Surveyor's Michigan License No. 24588

Date 11-05-96

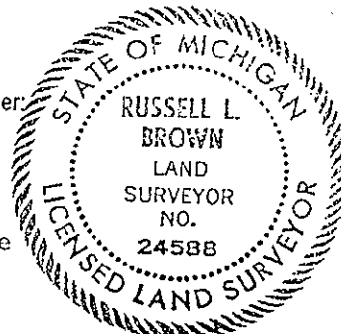

PEER GROUP APPROVED
AT MEETING 11-05-96.

Liber 1, Page 54 A

November 10, 1992 Act 74, L.C.R.C., Liber 1, Page 102 of Huron County Records.
1" Pipe in Monument Box
S52°W 72.92' to N and S in Power Pole
N45°W 53.00' to 1/2" ReBar
N64°E 63.95' to Nail in Power Pole

No surveys recorded or unrecorded found.

\$ 9.00 SURVEY
\$ 2.00 MSSR