

SURVEY &
REMONUMENTATION

MAR 19 1997

COMMISSION

1996

REMONUMENTATION

Re-Monumented, Page 65

LAND CORNER RECORDATION CERTIFICATE
Filing Requirement of Act 74, Mich. P.A. 1970

For corners in Bingham Township

<u>Huron County</u> (County)	Located In:	Corner Code #
1. Public Land Survey	T <u>15N</u> R <u>13E</u>	<u>L-13</u>
	T <u> </u> R <u> </u>	<u> </u>
	T <u> </u> R <u> </u>	<u> </u>
	T <u> </u> R <u> </u>	<u> </u>
2. Property Controlling in Section	S <u> </u> T <u> </u> R <u> </u>	<u> </u>
	S <u> </u> T <u> </u> R <u> </u>	<u> </u>
3. Miscellaneous Property in Sec.	S <u> </u> T <u> </u> R <u> </u>	<u> </u>
	S <u> </u> T <u> </u> R <u> </u>	<u> </u>

STATE OF MICHIGAN
HURON COUNTY
RECORDED

7 NOV 96 4:10 P.M.

FRANCES L. HOLDWICK
REGISTER OF DEEDS

Register of Deeds Stamp & File Number

4. Lot No. , Recorded Plat
5. Private Claims

I, Russell L. Brown, in a field survey on Oct. 7, 1996 do hereby state that under requirements of P.A. 74, Michigan P.A. of 1970, the corner points mentioned in lines 1 and 2 above were in conformance with regulations and rules therefore as required in the current manual of survey instructions of the United States Department of the Interior, Bureau of Land Management or by a decree of a Court of Law and/or that the corner points mentioned in lines 3, 4 and 5 above were in conformance with the rules of the Michigan Board of Land Surveyors or by a Decree of a Court of Law; established, re-established, monumented, recovered, found as expressed below:

NOTE: Not more than 2 corners, all in the same town and range, may be recorded on this certificate.

	A	B	C	D	E	F	G	H	I	J	K	L	M
1													
2	6		5		4		3		2		1		
3													
4	7		8		9		10		11		12		
5													
6	18		17		16		15		14		13		
7													
8	19		20		21		22		23		24		
9													
10	30		29		28		27		26		25		
11													
12	31		32		33		34		35		36		
13													

A. Description of original monument and accessories and/or subsequent restoration:

1834 G.L.O., H. Parké D.S.
Set quarter Post Section 36
Sugar 32", N45 1/2E 32 Links
DO 11", N70W 34 Links

June 15, 1883, Duncan McFadden County Surveyor
Set quarter Section post equidistant on line with
Southeast and Southwest Corners. No object stated,
No Witnesses given.

County Road Commission Records:
3/4" Steel Pin in Nest of Stones
In line with fence to North
(OVER)

Act 74 Form:
NONE

B. Description of corner evidence found and/or method applied in restoring or reestablishing corner:

Found 3/4" Steel Stake in approximate centerline of gravel road.


Accepted: Found 3/4" Steel Stake as the best evidence of original position corner of L-13.

C. Description of monument for corner and accessories established to perpetuate locating the position of the corner:

South 1/4 Corner of Section 36, T15N-R13E L-13
Found 3/4" Steel Stake

WITNESSES:

N45°W 39.51' to 1/2" Steel Stake Capped RLS 24588
S40°W 41.04' to 1/2" Steel Stake Capped RLS 24588
S40°E 43.86' to 1/2" Steel Stake Capped RLS 24588
N40°E 41.13' to 1/2" Steel Stake Capped RLS 24588

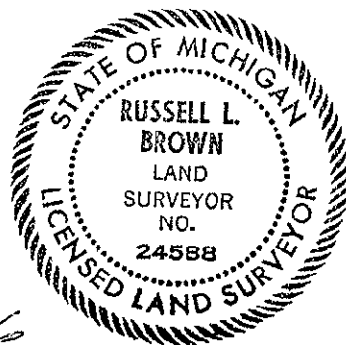

Signed by Russell L. Brown
Surveyor's Michigan License No. 24588

Date 11-05-96

PEER GROUP APPROVED

AT MEETING 11-05-96

Liber 1, Page 65A

May 16, 1973 Survey recorded in Liber 1 of Surveys, Page 485 of Huron County Records.
Found 3/4" Steel Pin

Spike in Northeast Side Power Pole, N20°W 67.10'

Spike in Northwest Side Anchor Pole, S50°W 49.75'

Spike in Northeast Side of Power Pole, S40°E 44.05'

\$ 9.00 SURVEY
\$ 2.00 MSSR