

SURVEY &
MONUMENTATION

JAN 19 2001

SECTION

2000 REMONUMENTATION
LAND CORNER RECORDATION CERTIFICATE
Filing Requirement of Act 74, Mich. P.A. 1970

For Corners in BINGHAM Township

Huron
(County)

Located in:

Corner Code #

1. Public Land Survey

T 15N R 13E

A - 2

T R

T R

T R

2. Property Controlling S
in Section S

T R

T R

3. Miscellaneous S
Property in Sec. S

T R

T R

4. Lot No. , Recorded Plat


5. Private Claims

STATE OF MICHIGAN
HURON COUNTY
RECORDED

8 DEC 2000 9:58 AM

FRANCES L. HOLDWICK
REGISTER OF DEEDS

Register of Deeds Stamp & File Number

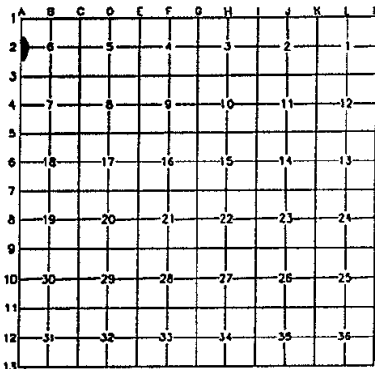

I, Russell L. Brown, in a field survey on June 16, 2000 do hereby state that under requirements of P.A. 74, Michigan P.A. of 1970, the corner points mentioned in lines 1 and 2 above were in conformance with regulations and rules therefore as required in the current manual of survey instructions of the United States Department of the Interior, Bureau of Land Management or by a decree of a Court of Law and/or that the corner points mentioned in lines 3, 4, and 5 above were in conformance with the rules of the Michigan Board of Land Surveyors or by a Decree of a Court of Law; established, re-established, monumented, recovered, found as expressed below:

NOTE: Not more than 2 corners, all in the same town and range, may be recorded on this certificate.

A. Description of original monument and accessories and/or subsequent restoration:

1834 G.L.O. H. Parke D.S. Set quarter Section Post East side Section 1, T15N-R12E
Cedar 12 N71W 10 1/2, B. Ash 12 S28 1/2W 33

COUNTY SURVEYOR RECORD - None

COUNTY ROAD COMMISSION RECORD - Monument, WITNESSES Iron Pin in fence S90°W 51.50', 5-11-00
FOUND 3/4" Iron Pin in Monument Box WITNESSES: S80°E 35.02' Rivet in 18" CMP, S45°E 52.66' Notch 18" CMP

L.C.R.C. - None

RECORDED SURVEY - continued next page


UNRECORDED SURVEY - None

B. Description of corner evidence found and/or method applied in restoring or reestablishing corner:

No evidence of original corner or accessories found.

Found 3/4" Dia. Re-Rod In Monument Box.

Accepted Found 3/4" Re-Rod as best evidence of original corner position.

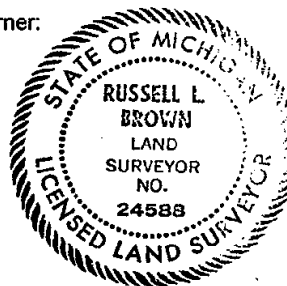

C. Description of monument for corner and accessories established to perpetuate locating the position of the corner:

A - 2, W. 1/4 Cor. Sec. 6, T15N-R13E

Found 3/4" Dia. Re-Rod in Monument Box

WITNESSES:

S80°E 35.11' Rivet Top N. end 18" C.M.P.

S45°E 52.64' Notch in South end 18" C.M.P.

N20°E 168.10' Spike in West face Power Pole

West 20.00' 1/2" Re-Rod Set

South 2628.00' A-3, S.W. Cor. Sec. 6, T15N-R13E

North 2611.53' A-1, N.W. Cor. Sec. 6, T15N-R13E

NOTE:

This corner is common with
M - 2, T15N-R12E

Signed by Russell L. Brown
Surveyor's Michigan License No. 24588

Date Nov. 2, 2000

Peer group approved at meeting held November 2, 2000. RLB

SURVEY &
DOCUMENTATION

JAN 19 2001

SECTION

Re-Monumented, Page 116

2000 REMONUMENTATION
LAND CORNER RECORDATION CERTIFICATE
Filing Requirement of Act 74, Mich. P. A. 1970

For Corners in BINGHAM Township,

Huron County, T15N-R13E
A-2 Continued

RECORDED SURVEYS:

9-29-76, Case Surveying, Stewart G. Case P.S. 15399, Liber 3 Surveys, Page 78 of Huron County Records.

West ¼ Cor. Frac. Sec. 6, T15N-R13E

Found Monument Box in place in center of Road Grade

WITNESSES:

½" Iron Pin, East 47.4'

½" Iron Pin, West 46.6'

Nail in West side of Power Pole, N30°E 168.23'

