

JAN 19 2001

SECTION

Re-Mon Liber 2, Page 112

2000 REMONUMENTATION LAND CORNER RECORDATION CERTIFICATE Filing Requirement of Act 74, Mich. P.A. 1970

For Corners in BINGHAM Township

Huron (County)	Located in:	Corner Code #
1. Public Land Survey	T 15N R 13E	A - 4
	T _____ R _____	
	T _____ R _____	
	T _____ R _____	
2. Property Controlling S in Section S	T _____ R _____	
	T _____ R _____	
3. Miscellaneous S Property in Sec. S	T _____ R _____	
	T _____ R _____	


STATE OF MICHIGAN
HURON COUNTY
RECORDED

8 DEC 2000 9:58 AM

FRANCES L. HOLPWICK
REGISTER OF DEEDS

Register of Deeds Stamp & File Number

- 4. Lot No. _____, Recorded Plat _____
- 5. Private Claims _____

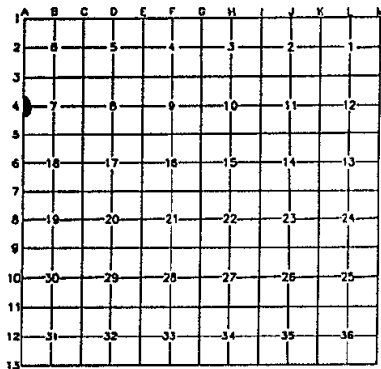


I, Russell L. Brown, in a field survey on June 16, 2000 do hereby state that under requirements of P.A. 74, Michigan P.A. of 1970, the corner points mentioned in lines 1 and 2 above were in conformance with regulations and rules therefore as required in the current manual of survey instructions of the United States Department of the Interior, Bureau of Land Management or by a decree of a Court of Law and/or that the corner points mentioned in lines 3, 4, and 5 above were in conformance with the rules of the Michigan Board of Land Surveyors or by a Decree of a Court of Law; established, re-established, monumented, recovered, found as expressed below:

NOTE: Not more than 2 corners, all in the same town and range, may be recorded on this certificate.

A. Description of original monument and accessories and/or subsequent restoration:
 1834 G.L.O. H. Parke D.S. Set quarter section post East side Section 12, T15N-R12E,
 Maple 17 N34W 24 1/2, DO 9 S22W 34
 COUNTY SURVEYOR RECORD - None
 COUNTY ROAD COMMISSION RECORD - Monument: WITNESSES: Spike N.W. Side P.P. N75E 56.25', Spike S. Side F.P. S90°W 49.15', FOUND 3/4" Iron in Monument Box: WITNESSES: S80°W 77.37' Spike 42" Red Maple N75°E 56.32' Spike in P.P., S45°E 83.56' Spike in P.P.
 L.C.R.C. - None
 RECORDED SURVEY - continued next page
 UNRECORDED SURVEY - None

B. Description of corner evidence found and/or method applied in restoring or reestablishing corner:
 No evidence of original corner or accessories found.
 Found 3/4" Dia. Re-Rod in Monument Box.
 Accepted found 3/4" Dia. Re-Rod as best evidence of original corner position.

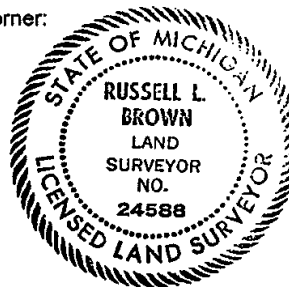

C. Description of monument for corner and accessories established to perpetuate locating the position of the corner:
 A- 4, W. 1/4 Cor. Sec. 7, T15N-R13E
 Found 3/4" Dia. Re-Rod in Monument Box
 WITNESSES:
 N75°E 56.32' to Spike in N. face of Power Pole
 S45°E 83.56' to Spike in N.E. face of Power Pole
 S80°W 77.37' to Spike in N. face of 48" Red Maple
 N85°W 62.40' to Spike in S. face of 6" Ash Tree
 South 2638.89' to A-5, S.W. Cor. Sec. 7, T15N-R13E
 North 2643.09' to A-3, N.W. Cor. Sec. 7, T15N-R13E

NOTE:
This corner is common with
M - 4, T15N-R12E

Signed by Russell L. Brown Date Nov. 2,
Surveyor's Michigan License No. 24588

Peer group approved at meeting held November 2, 2000. RLB

JAN 19 2001

SECTION

Re-Monumentation, Page 112 A

2000 REMONUMENTATION
LAND CORNER RECORDATION CERTIFICATE
Filing Requirement of Act 74, Mich. P. A. 1970

For Corners in BINGHAM Township,

Huron County, T15N-R13E

A - 4 Continued

RECORDED SURVEY:

3-22-77, Case Surveying, Stewart G. Case P.S. 15399, Liber 3 Survey, Page 223 of Huron County Records.
West ¼ Cor. Sec. 7, T15N-R13E

Found ¼" Steel Pin in Monument Box in place

WITNESSES:

Spike in N. W. Side of Power Pole, N65°E 56.35'

Spike in N. Side of 30: Maple Tree, S80°W 77.60'

½" Steel Pin, N70°W 44.0'

1-31-80, Case Surveying, Stewart G. Case P.S. 15399, Liber 4 Surveys, Page 263 of Huron County Records.

West ¼ Cor. Sec. 7, T15N-R13E,

Same object and accessories as Liber 3 Surveys, Page 223 of Huron County Records.

