

JAN 19 2001

2000 REMONUMENTATION

Re-Mon. Liber 2, Page 61

SECTION

LAND CORNER RECORDATION CERTIFICATE
Filing Requirement of Act 74, Mich. P.A. 1970

For corners in

Huron

(County)

Located in:

Corner Code #

1. Public Land Survey Sand Beach T16N R15E A-7
T R
T R
T R
2. Property Controlling S T R
in Section S T R
3. Miscellaneous S T R
Property in Sec. S T R

STATE OF MICHIGAN
HURON COUNTY
RECORDED

20 SEP 2000 2:02 PM

FRANCES L. HOLDWICK
REGISTER OF DEEDS

Register of Deeds Stamp & File Number

4. Lot No. , Recorded Plat
5. Private Claims

I, Charles S. Getz, in a field survey on May 17, 2000, do hereby state that under requirements of P.A. 74, Michigan P.A. of 1970, the corner points mentioned in lines 1 and 2 above were in conformance with regulations and rules therefore as required in the current manual of survey instructions of the United States Department of the Interior, Bureau of Land Management or by a decree of a Court of Law and/or that the corner points mentioned in lines 3, 4 and 5 above were in conformance with the rules of the Michigan Board of Land Surveyors or by a Decree of a Court of Law; established, re-established, monumented, recovered, found as expressed below:

NOTE: Not more than 2 corners, all in the same town and range, may be recorded on this certificate.


1	A	B	C	D	E	F	G	H	I	J	K	L
2		6		5		4		3		2		1
3												
4		7		8		9		10		11		12
5												
6		18		17		16		15		14		13
7												
8		19		20		21		22		23		24
9												
10		30		29		28		27		26		25
11												
12		31		32		33		34		35		36
13												

A. Description of original monument and accessories and/or subsequent restoration:
A-7 1834 G.L.O., H. Parke D.S. County Road Commission Records - Iron Pin
Set Post
Hemlock 24", N23°W, 4 1/2 Links Recorded Surveys - NONE
Do. 12", S5°W, 14 Links Unrecorded Surveys - NONE
L.C.R.C. - NONE

County Surveyor Records -
NONE

B. Description of corner evidence found and/or method applied in restoring or reestablishing corner:
A-7
SW Cor, Section 18, T16N-R15E
Found 1/2" Iron Bar
Accepted as the best available evidence
of the original corner position
(On Finkel Road)

C. Description of monument for corner and accessories established to perpetuate locating the position of the corner:
A-7
SW Cor, Section 18, T16N-R15E
Found 1/2" Iron Bar
West 33.80' to Nail in Wooden Fence Post
East 27.00' to Metal Fence Post
S20°E 141.85' to Nail in Power Pole
South 2624.80' to W 1/4 Cor, Sec 19, T16N-R15E
North 2627.85' to W 1/4 Cor, Sec 18, T16N-R15E

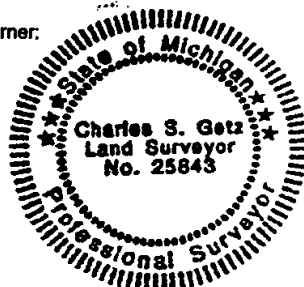

Signed by Charles S. Getz

Date June 10, 2000

Surveyor's Michigan License No. 25843

PEER GROUP APPROVED AT MEETING
HELD September 18, 2000. RLB