

Common to:
M01 - Caseville Twp. - T17N-R10E
M13 - Caseville Twp. - T18N-R10E
A13 - Lake Twp. - T18N-R11E

Re-Mon. Liber 2, Page 2

1999 REMONUMENTATION

LAND CORNER RECORDATION CERTIFICATE
Filing Requirement of Act 74, Mich. P.A. 1970

For Corners in

Huron
(County)

Located in:

Corner Code #

1. Public Land survey: Chandler T 17_N R 11_E A-1
T _____ R _____
T _____ R _____
T _____ R _____
2. Property Controlling S _____ T _____ R _____
in Section S _____ T _____ R _____
3. Miscellaneous S _____ T _____ R _____
Property in Sec. S _____ T _____ R _____
4. Lot No. _____, Recorded Plat _____
5. Private Claims _____

RECORDED

DEC 20 4 18 PM '99

Frances Holtenich
REGISTER OF DEEDS
HURON COUNTY, MICHIGAN

Register of Deeds Stamp & File Number

I, James T. Meek, in a field survey on October 30, 1999,
do hereby certify that under requirements of P.A. 74, Michigan P.A. of 1970, the corner points mentioned
in lines 1 and 2 above were in conformance with regulations and rules thereof as required in the
current manual of survey instructions of the United States Department of the Interior, Bureau of Land
Management or by a decree of a Court of Law and/or that the corner points mentioned in lines 3, 4 and 5
above were in conformance with the rules of the Michigan Board of Land Surveyors or by a Decree of a
Court of Law; established, re-established, monumented, re-monumented, recovered, found as
expressed below:

NOTE: Not more than 2 corners, all in the same town and range, may be recorded
on this certificate.

A. Description of original monument and accessories and/or subsequent restoration:
Original survey, T17NR11E, 1835, Harvey Parke D.S.

A-1 Corner of Townships 17 and 18 North, Ranges 10 and 11 East
Post
White Ash 10", S14½°W, 74 links
Maple 22", N44°E, 51 links

County Surveyor's Record: none
Recorded Surveys: none
LCRC: none

B. Description of corner evidence found and/or method applied in restoring or reestablishing corner:

A-1 Corner of Townships 17 and 18 North, Ranges 10 and 11 East

Found 2" pipe extending 1' above ground

Accepted as the best available evidence of the original corner position.


C. Description of monument for corner and accessories established to perpetuate locating the position of the corner:

A-1 Corner of Townships 17 and 18 North, Ranges 10 and 11 East

2" pipe extending 1' above ground

From which:

Tag in 14" walnut bears S10°W, 36.2'
Tag in 24" maple bears S60°W, 53.0'
Tag in 14" triple maple bears N85°E, 19.4'
Tag in 12" maple bears S70°E, 27.6'

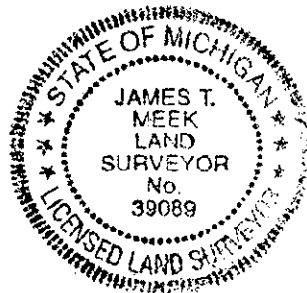

Signed by James T. Meek

Date 12-21-99

Surveyor's Michigan License No. 39089

APPROVED AT PEER BOARD MEETING 12-16-99 RLB