

SURVEY & REMONUMENTATION

LIBER 8 PAGE 260

OCT 26 11:39 AM '94

APR 10 1995

LAND CORNER RECORDATION CERTIFICATE

Filing Requirement of Act 74, Mich. P.A. 1970

For corners in

INGHAM
(County)

Located In:

Corner Code #

REGISTER OF DEEDS
INGHAM COUNTY, MICH.

- STOCKBRIDGE TOWNSHIP
Public Land Survey T 1N R 2E D-1
T _____ R _____
T _____ R _____
T _____ R _____
- Property Controlling S _____ T _____ R _____
in Section S _____ T _____ R _____
- Miscellaneous S _____ T _____ R _____
Property in Sec. S _____ T _____ R _____
- Lot No. _____, Recorded Plat _____
- Private Claims _____

Register of Deeds Stamp & File Number

I, David Clifford, in a field survey on May 14, 19 94, do hereby certify that under requirements of P.A. 74, Michigan P.A. of 1970, the corner points mentioned in lines 1 and 2 above were in conformance with regulations and rules therefore as required in the current manual of survey instructions of the United States Department of the Interior, Bureau of Land Management or by a decree of a Court of Law and/or that the corner points mentioned in lines 3, 4 and 5 above were in conformance with the rules of the Michigan Board of Land Surveyors or by a Decree of a Court of Law; established, re-established, monumented, re-monumented, recovered, found as expressed below:

NOTE: Not more than 4 corners, all in the same town and range, may be recorded on this certificate.

A. Description of original monument and accessories and/or subsequent restoration:

- Corner not set in original government surveys
- Corner set by W.A. Rowe Co. Surveyor in Oct 1895 recorded in field book 15 page 36. Rowe based his location of this corner on an "old unrecorded survey" in the N.W. $\frac{1}{4}$ of Sec. This old survey was probably done by J. Yokum former Washtenaw Co. Surveyor who makes reference to such a survey done in 1878 in his private records (now in the possession of Wolverine Engineers) with no mention of mon. or witnesses.


(OVER)

B. Description of corner evidence found and/or method applied in restoring or reestablishing corner:

Searched at apparent location of corner and found Anchor post hole. Traversed Township line and set standard Bar and Cap in Anchor Post hole on Township line. All of my witnesses of 1988 and 2 of R. Lester witnesses of 1973 are still standing and match location of corner. Measured East 195.36' (Rowes 1895 dist.) to D-13 White Oak and measured N25°E 198.7' to remains of a large Oak stump (Rowes 1895 witness). Accepted bar and cap as exact location of corner as set by W.A. Rowe in 1895. Measured West 2649.67 feet to C-1. Measured East 2659.05 to E-1. Measured South 2591.19 to D-2

C. Description of monument for corner and accessories established to perpetuate locating the position of the corner:

Standard Ingham County Remonumentation 3/4" Bar and PA 345 Cap PS 25837
Set nail & tag #25837 in S. Side 8" Cherry NAZ 318° 53.80'
Set nail & tag #25837 in E. Side 12" Cherry NAZ 190° 16.20'
Found nail & tag #25837 in S.E. Side 20" Quad. Cherry NAZ 38° 46.12'
Set nail & tag #25837 in E. Side 18" Cherry NAZ 0° 56.58'
Standard 3/4" Bar and PA 345 Cap PS 25837 at D-13 White Oak NAZ 92° 195.36'

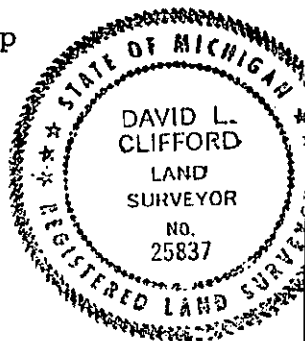

Signed by David Clifford Date AUGUST 9 1994

Surveyor's Michigan License No. 25837

2. (Cont.) Rowe set an iron shaft 2.96 chains (195.36') West of the South $\frac{1}{4}$ Post of Sec. 32, T2N, R2E
W.O. 30" N25E 301 lks (198.66')
Hick 8" S16E 284 lks (187.44')
3. R. Lester LS #18998 recorded corner in Liber 2 of corners page 471 in June 1973 and used in a survey recorded in Liber 1 of Surveys page 857 as a set $\frac{1}{2}$ " bar on townline and fence line South.
N&T East side 10" Cherry North 56.58'
N&T N. Side 5" Elm WSW 70.20'
N&T E. Side 8" Cherry NE 46.12'
4. M. Fouty LS #18989 used corner in a survey recorded in Liber 5 of Surveys page 857 in Aug. 1986 with the same mon. and witnesses as in item 3.
5. Corner recovered by this surveyor in Aug. 1988 during the Super Collider Project
Found Post hole.
N&T 5" Cherry NW 53.8'
N&T 16" Cherry North 56.58' (Lester witness)
N&T 12" Cherry 46.12' (Lester witness)
N&T in tree SW 16.2'