

DEC 16 1996

COMMISSION

LAND CORNER RECORDATION CERTIFICATE

Filing Requirement of Act 74, Mich. P.A. 1970
WHEATFIELD TOWNSHIP

Liber 9 Page 1

For corners in

INGHAM
(County)

Located In:

Corner Code #

1. Public Land Survey

T 3N R 1E

C-1

2. Property Controlling
in Section


S T R

3. Miscellaneous
Property in Sec.

S T R

4. Lot No. , Recorded Plat

5. Private Claims

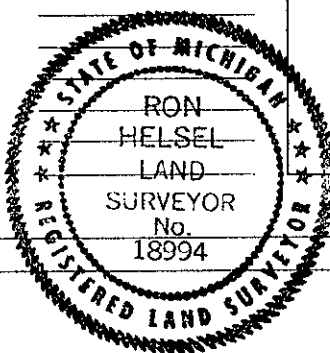

FILED

960037630
10/01/1996 11:13:20
REGISTER OF DEEDS
Paula Johnson
INGHAM COUNTY, MI

Register of Deeds Stamp & File Number

	A	B	C	D	E	F	G	H	I	J	K	L	M
2	6		5		4		3		2		1		
3													
4	7		8		9		10		11		12		
5													
6	18		17		16		15		14		13		
7													
8	19		20		21		22		23		24		
9													
10	30		29		28		27		26		25		
11													
12	31		32		33		34		35		36		
13													

I, RON HELSEL, in a field survey on SEPT. 12, 19 96,
do hereby certify that under requirements of P.A. 74, Michigan P.A. of 1970, the corner points mentioned
in lines 1 and 2 above were in conformance with regulations and rules therefore as required in the
current manual of survey instructions of the United States Department of the Interior, Bureau of Land
Management or by a decree of a Court of Law and/or that the corner points mentioned in lines 3, 4 and 5
above were in conformance with the rules of the Michigan Board of Land Surveyors or by a Decree of a
Court of Law; established, re-established, monumented, re-monumented, recovered, found as
expressed below:

**NOTE: Not more than 4 corners, all in the same town and range, may be recorded
on this certificate.**

A. Description of original monument and accessories and/or subsequent restoration:

ORIGINAL MONUMENT: POST SET BY J. WAMPLER, U.S. DEPUTY SURVEYOR, MARCH, 1826,
74 LINKS WEST OF POST

BEECH 8", S15 1/2W, 27 LINKS

BEECH 8", S49°E, 44 LINKS

1) A SURVEY WAS RECORDED IN LIBER 3, PGS. 578 & 579, FIELD DATED NOV. 03, 1977
BY A. PIERSON P.S. NO. 13039. HIS SURVEY IGNORED THIS CORNER AND LINE WAS
RAN FROM D-1 TO A-1 ALONG THE TOWNSHIP LINE.

2) DID NOT FIND FURTHER MENTION OF THIS CORNER IN PUBLIC OR PRIVATE RECORDS.

B. Description of corner evidence found and/or method applied in restoring or reestablishing corner:

NO EVIDENCE WAS FOUND IN THE PROBABLE AREA OF THIS CORNER. OWNERSHIP BOTH
NORTH AND SOUTH OF THE TOWNSHIP LINE HAS BEEN DEEDED WITH SECTIONS 5 & 6
ALONG WITH SECTIONS 31 & 32 AS PARENT PARCELS, RESPECTIVELY. DEEMED
THIS CORNER TO BE LOST AND SET THE CORNER AT THE GOVERNMENT FALLING OF 74
LINKS WEST OF C-13 (T4N, R1E). CORNER LANDED IN THE SOUTH EDGE OF A 14"
W. CHERRY. SET 3/4" X 24" STANDARD FORM PIN & CAP 3.00 FEET SOUTH OF THE
CORNER ON LINE WITH C-2 (1/4 COR. COMMON TO SEC. 5 & SEC. 6).

C. Description of monument for corner and accessories established to perpetuate locating the position of the corner:

3/4" X 24" STEEL FORM PIN WITH CAP LABELED P.A. 345, P.S. NO. 18994 3.00 FEET
SOUTH AND ON SECTION LINE TO SOUTH.

SET NAIL & TAG NO. 18994 ON SOUTH/SIDE POWER POLE AZ. 288°, 46.35 FEET

SET NAIL & TAG NO. 18994 ON EAST/SIDE 14" W. CHERRY AZ. 08°, 3.32 FEET

SW COR. OF CONC. DRIVEWAY TO HOUSE #3560 az. 43°, 67.99 FEET

SE COR. OF CONC. DRIVEWAY TO HOUSE #3560 AZ. 59°, 88.41 FEET

Signed by

Ron Helsel

Date SEPT. 18, 1996

Surveyor's Michigan License No.

18994