

DEC 1 2 1997

COMMISSION

LAND CORNER RECORDATION CERTIFICATE
Filing Requirement of Act 74, Mich. P.A. 1970

For corners in

Liber 9 Page 224

FILED

970041151
10/20/1997 13:41:27
REGISTER OF DEEDS
Paula Johnson
INGHAM COUNTY, MI

Register of Deeds Stamp & File Number

INGHAM (County) Located In: ALAIEDON TOWNSHIP Corner Code # K-7

1. Public Land Survey T 3N R 1W
T R
T R
T R

2. Property Controlling S T R
in Section S T R

3. Miscellaneous S T R
Property in Sec. S T R

4. Lot No. , Recorded Plat
5. Private Claims

I, RON HELSEL, in a field survey on JUNE 30, 1997
do hereby certify that under requirements of P.A. 74, Michigan P.A. of 1970, the corner points
mentioned in lines 1 and 2 above were in conformance with regulations and rules therefore as
required in the current manual of survey instructions of the United States Department of the Interior,
Bureau of Land Management or by a decree of a Court of Law and/or that the corner points
mentioned in lines 3, 4 and 5 above were in conformance with the rules of the Michigan Board of
Land Surveyors or by a Decree of a Court of Law; established, re-established, monumented,
re-monumented, recovered, found as expressed below:

NOTE: Not more than 4 corners, all in the same town and range, may be recorded
on this certificate.


A. Description of original monument and accessories and/or subsequent restoration:
ORIGINAL MONUMENT: POST SET BY MUSGROVE EVANS, U.S. DEPUTY SURVEYOR,
MARCH 13, 1826. WITNESSED AS: SUGAR 8", N66W, 9 LINKS
BEECH 4", N82E, 11 LINKS

- VOL. 1, PAGE 327, COUNTY SURVEYOR A. JACKSON, DEC. 14, 1853, CITED ORIGINAL WITNESSES ABOVE.
- VOL. 2, PAGE 81, COUNTY SURVEYOR T. J. BROWN, MAY 12, 1870, CITED A POST FROM WHICH A ELM 24", BEARS
S45 3/4W, 55 1/2 LINKS.
- VOL. 2, PAGE 152, COUNTY SURVEYOR, A.P. DRAKE, JUNE 15, 1877, CITED A POST, SAME AS BROWN ABOVE.
- I.C.R.C. GRID MAP CALLED FOR IRON TO SURFACE WITNESSED AS:
ELM, NE, 54.3' (GONE)
U.S.G.S. POST, N.W., 36.4' (GONE)
ELM, 20", SSE, 57.5' (GONE)
(CONTINUED ON BACK)

B. Description of corner evidence found and/or method applied in restoring or reestablishing corner:
EXCAVATED AND FOUND A 3/8" X 8" REBAR 5" BELOW SURFACE OF ROAD 4.5 FEET WEST OF CENTERLINE OF EVERY ROAD
AND ON CENTERLINE OF HOLT ROAD. AT 2.0' DEEP FOUND A BENT 3/4" PIPE WRAPPED IN COPPER WIRE AT SURFACE OF OLD P
GRAVEL AND TAR ROAD, LYING DIRECTLY UNDER THE POSITION OF THE 3/8" REBAR. AT 2.5 FEET FOUND OLD CLAY ROAD BED
EXCAVATED TO 3 FEET BUT DID NOT FIND ANY FURTHER EVIDENCE OF CORNER. ACCEPTED THE POSITION OF THE PIPE AND
REBAR AS FAITHFUL PERPETUATION OF THE CORNER. LEFT BENT 3/4" PIPE IN PLACE AND SET A 3/4" FORM PIN AND CAP
STAMPED P.A. 345, P.S. NO. 18994 IN A MONUMENT BOX AT SURFACE OF ROAD.

C. Description of monument for corner and accessories established to perpetuate locating the position of the corner:
3/4" FORM PIN AND CAP 4.5 FEET WEST OF CENTERLINE OF EVERY ROAD ON CENTERLINE OF HOLT ROAD IN MON. BOX.

FOUND NAIL AND TAG NO. 25832, NORTH/SIDE POWER POLE, AZ. 70 DEG., 65.30 FEET
FOUND NAIL AND TAG NO. 18998, EAST/SIDE 30" OAK, AZ. 202 DEG., 98.90 FEET
SE CORNER OF CONCRETE BLOCK PLANTER, AZ. 221 DEG., 69.95 FEET
SET NAIL AND TAG NO. 18994 WEST/SIDE 12" ELM, AZ. 30 DEG., 83.50 FEET
SET 1/2" IRON BAR AND CAP NO. 18994 AT EDGE OF ASPHALT ROAD, AZ. 322 DEG., 27.97 FEET

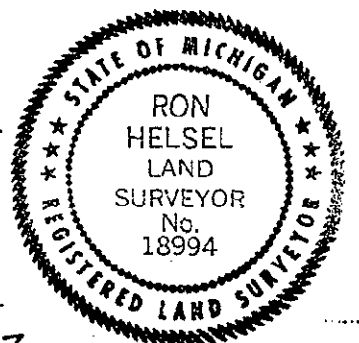

Signed by Ron Helsel

Date SEPT 27, 1997

Surveyor's Michigan License No. 18994

FORM APPROVED BY MICHIGAN STATE BOARD OF LAND SURVEYORS, JAN/28,
REVISED MAY/14
REVISED JAN..

P.A. 345-INGHAM COUNTY
PEER APPROVED 9/25/97

A. (CONTINUED)

- 4) A SURVEY WAS RECORDED IN LIBER 3, PAGES 128-129, DATED 6/29/77, BY A. WILLIAMS, P.S. NO. 21275. L.C.R.C., LIBER 3, PG. 313 WAS CITED. (WRONG LIBER AND PAGE) NO WITNESSES OR DESCRIPTION OF MONUMENT.
- 5) A L.C.R.C. WAS RECORDED IN LIBER 4, PAGE 132, FIELD DATED 1-6-78, BY G. YOUNG P.S. NO. 17640. "FOUND 3/8" ROD 0.2' UNDER ASPHALT."
 WITNESSED AS: PK NAIL IN POWER POLE, N45E, 64.21' (FOUND POWER POLE BY ...)
 # 60 NAIL AND CAP IN 30" OAK, S15W, 98.05' (FOUND 30" OAK)
 COR. CONCRETE BLOCK PLANTER S20W, 69.95' (FOUND)
- 6) A SURVEY WAS RECORDED IN LIBER 3, PAGE 618, DATED NOV. 1, 1978 BY G. YOUNG, P.S. NO. 17640. HE CITED THE SAME MONUMENT AND WITNESSES AS 5-A ABOVE.
- 7) SURVEYS WERE RECORDED IN LIBER 3, PAGE 713, DATED DEC. 1978 AND IN LIBER 4, PAGES 144-145, DATED SEPT. 1980 BY A. WILLIAMS. NO MONUMENT WAS DESCRIBED AND THE WITNESSES WERE BOGUS.
- 8) A SURVEY WAS RECORDED IN LIBER 4, PAGE 61, DATED MAY 27, 1980 BY G. YOUNG. HE CITED THE SAME MONUMENT AND WITNESSES AS 5-A ABOVE.
- 9) A SURVEY WAS RECORDED IN LIBER 4, PAGES 1213-1214, DATED, FEB., 1986 BY R. LESTER, P.S. NO. 18998. HE CITED LIBER 4, PAGE AND WITNESSED AS: NAIL & TAG #25832 IN NORTHWEST SIDE POWER POLE, N.E., 65.3'
 SE COR. OF BLOCK PLANTER, S20W, 69.95'
 NAIL & CAP IN 30" OAK, S15W, 98.08'
- 10) SURVEYS WERE RECORDED IN LIBER 6, PAGES 223-224, DATED FEB. 3, 1988 AND IN LIBER 7, PAGES 260-261, DATED SEPT. 9, 1986 (RECORDING DATE, JUNE 17, 1994), BY L. BRYAN P.S. NO. 25832. HE CALLED FOR A 3/8" BAR 4' WEST CENTERLINE OF EVERY ROAD IN CENTERLINE OF HOLT ROAD. CENTERLINE OF U.S.G.S. MONUMENT, N45W, 36.80' (GONE)
 SET NAIL AND TAG NORTHWEST SIDE POWER POLE, N60E, 63.35' (FOUND)
 FOUND NAIL AND TAG, EAST SIDE 24" OAK, S15W, 98.08' (FOUND OAK TREE),

FILED