

DEC 1 2 1997

COMMISSION

LAND CORNER RECORDATION CERTIFICATE
Filing Requirement of Act 74, Mich. P.A. 1970

For corners in

Liber 9 Page 228

INGHAM

(County)

Located In:

Corner Code #

ALAIEDON TOWNSHIP

1. Public Land Survey

T3N R1W

M-4

2. Property Controlling
in Section

S

T

R

3. Miscellaneous
Property in Sec.

S

T

R

S

T

R

4. Lot No. , Recorded Plat

5. Private Claims

FILED

970041353
10/20/1997 13:41:31
REGISTER OF DEEDS
Paula Johnson
INGHAM COUNTY, MI

Register of Deeds Stamp & File Number

	A	B	C	D	E	F	G	H	I	J	K	L
1												
2		6		5		4		3		2		1
3												
4		7		8		9		10		11		12
5												
6		18		17		16		15		14		13
7												
8		19		20		21		22		23		24
9												
10		30		29		28		27		26		25
11												
12		31		32		33		34		35		36
13												

I, RON HELSEL, in a field survey on JUNE 6, 1997
do hereby certify that under requirements of P.A. 74, Michigan P.A. of 1970, the corner
points mentioned in lines 1 and 2 above were in conformance with regulations and rules
therefore as required in the current manual of survey instructions of the United States
Department of the Interior, Bureau of Land Management or by a decree of a Court of Law
and /or that the corner points mentioned in lines 3, 4 and 5 above were in conformance
with the rules of the Michigan Board of Land Surveyors or by a Decree of a Court of Law;
established, re-established, monumented, re-monumented, recovered, found as expressed
below:

NOTE: Not more than 4 corners, all in the same town and range, may be recorded
on this certificate.

A. Description of original monument and accessories and/or subsequent restoration:

ORIGINAL MONUMENT: POST SET BY J. WAMPLER, U.S. DEPUTY SURVEYOR, DEC. 1826. BEECH 10", N60W 26 LINKS;
BEECH 6", S30W 17 LINKS.

1) VOL. 2, PAGE 153, DATED JAN. 10-11, 1878, COUNTY SURVEYOR A.P. DRAKE CITED THIS CORNER AS A POST; W. ASH 16",
N31 3/4E, 25 LINKS; BEECH 16", S33 1/2 W, 102 1/2 LINKS.

2) A L.C.R.C. WAS RECORDED IN LIBER 3, PAGE 608, FIELD DATED JULY 13, 1976, BY R. LESTER NO. 18998. "SET 1/2" BAR AND
CAP MIDWAY AND ON LINE BETWEEN THE N.E. CORNER AND THE S.E. CORNER OF SECTION 12. CORNER FALLS 2.4' SOUTH OF A
FENCE WEST AND 3.0' EAST OF THE CENTERLINE OF ROAD."

NAIL AND TAG IN NORTH SIDE OF 2" ELM, WEST, 37.53'

1/2" BAR AT EAST EDGE OF MERIDIAN ROAD ASPHALT, N.E., 27.68' (FOUND)

1/2" BAR AT EAST EDGE OF MERIDIAN ROAD ASPHALT, EAST, 9.39' (FOUND)


(CONTINUED ON BACK)

B. Description of corner evidence found and/or method applied in restoring or reestablishing corner:

FOUND 1/2" IRON BAR 6" BELOW ASPHALT PAVEMENT 3.0 FEET EAST OF & OF MERIDIAN ROAD AND 2.5 FEET SOUTH OF A
TREE ROW OF 4" TO 6" ELM TO THE WEST. EXCAVATED THROUGH 2 LAYERS OF ASPHALT DOWN TO NATURAL GROUND 2' ±
BELOW SURFACE OF ROAD. FOUND SOME VERY SMALL PIECES OF BRICK BUT NOTHING ELSE. ACCEPTED THE POSITION OF THE
1/2" BAR AS THE BEST PROCEDURE FOR SETTING A LOST CORNER. REPLACE 1/2" BAR WITH A 3/4" X 24" FORM PIN AND CAP
STAMPED P.A. ACT 345, P.S. NO. 18994. SET MON. BOX TO PAVEMENT SURFACE.

C. Description of monument for corner and accessories established to perpetuate locating the position of the corner:

3/4" PIN AND CAP 3.0 FEET EAST OF & OF MERIDIAN ROAD IN MONUMENT BOX.
FOUND 1/2" IRON BAR AT EAST EDGE OF PAVEMENT MERIDIAN ROAD, AZ. 96 DEG., 9.39 FEET
FOUND 1/2" IRON BAR AT EAST EDGE OF PAVEMENT MERIDIAN ROAD, AZ. 27 DEG., 27.66 FEET
SET NAIL AND TAG NO. 18994 SOUTH/SIDE OF SERVICE POLE, AZ. 278 DEG., 32.24 FEET
SET NAIL AND TAG NO. 18994 EAST/SIDE OF POWER POLE, AZ. 343 DEG., 76.81 FEET
FOUND 1/2" IRON BAR, WEST, 32.92 FEET.

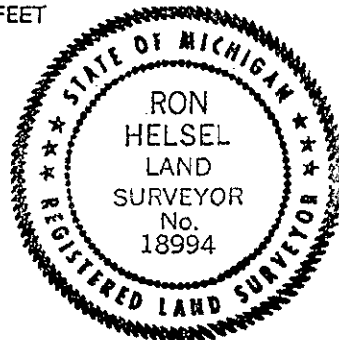

Signed by

Date

SEPT. 27, 1997

Surveyor's Michigan License No.

18994

A (CONTINUED)

3) SURVEYS WERE RECORDED IN LIBER 2, PAGES 939-943, DATED JULY 26, 1976, IN LIBER 2, PAGES 1050-1053, DATED NOV. 24, 1976, I LIBER 3, PAGES 44-45, DATED APRIL 22, 1977, AND IN LIBER 3, PAGES 343-345, DATED MAY 5, 1978 BY R. LESTER. HE CALLED FOR AND WITNESSED THE CORNER SAME AS 2-A ABOVE.

LTED