

SURVEY &
REMONUMENTATION

APR 27 1995

COMMISSION IOSCO COUNTY REMONUMENTATION CORNER
LAND CORNER RECORDATION CERTIFICATE
Filing Requirement of Act 74, Mich. P.A. 1970

STATE OF MICHIGAN
IOSCO COUNTY
FILED

5 DEC 94 2:02 P.M.

BONITA M. COYLE
REGISTER OF DEEDS

94-42

Register of Deeds Stamp & File Number

For corners in
IOSCO

(County)

Located In:

Corner Code ##

No. 2

1. Public Land Survey

T23N R 9E

H-5 to I-5

T R

T R

T R

2. Property Controlling
in Section

S T R

S T R

3. Miscellaneous
Property in Sec.

S T R

S T R

4. Lot No. , Recorded Plat

5. Private Claims

	A	B	C	D	E	F	G	H	I	J	K	L	M
2	6	5	4	3	2	1							
3													
4	7	8	9	10	11	12							
5													
6	18	17	16	15	14	13							
7													
8	19	20	21	22	23	24							
9													
10	30	29	28	27	26	25							
11													
12	31	32	33	34	35	36							
13													

I, John F. Oliver in a field survey on October 3, 19 94,
do hereby certify that under requirements of P.A. 74, Michigan P.A. of 1970, the corner points mentioned
in lines 1 and 2 above were in conformance with regulations and rules therefore as required in the
current manual of survey instructions of the United States Department of the Interior, Bureau of Land
Management or by a decree of a Court of Law and/or that the corner points mentioned in lines 3, 4 and 5
above were in conformance with the rules of the Michigan Board of Land Surveyors or by a Decree of a
Court of Law; established, re-established, monumented, re-monumented, recovered, found as
expressed below:

NOTE: Not more than 4 corners, all in the same town and range, may be recorded
on this certificate.

A. Description of original monument and accessories and/or subsequent restoration:

1844 Original Survey by William Johnston, Set Wood Post
10" S. Pine N88°W 94 links
8" S. pine S39°W 132 links

1956 Subdivision by R.J. Cooke AuSable point Beach No.6 (L.7, P. 27-28)
indicates concrete monument at corner position, Monument Not found

B. Description of corner evidence found and/or method applied in restoring or reestablishing corner:

1994 accept position as established by subdivision, monument not found
set 5/8" re-bar and aluminum cap at SE corner of Lot 1, AuSable Point
Beach #6


ACCEPTED BY THE IOSCO COUNTY
SURVEY PEER GROUP AS THE
OFFICIAL CORNER UNDER P.A.
345 OF 1990 AT A MEETING
HELD ON 11-10-94

James H. Drayner

C. Description of monument for corner and accessories established to perpetuate locating the position of the corner:

5/8" re-bar with aluminum Cap

NE Corner Brick House S83°W 64.58
SE Corner Brick House S69°W 74.42
15" White Pine S80°W 45.52
12" White Pine N10°W 77.30

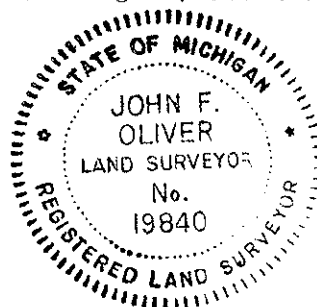

Signed by

Date

11-11-94

Surveyor's Michigan License No. 19840