

SURVEY & REMONUMENTATION

MAY 07 1997

IOSCO COUNTY REMONUMENTATION
LAND CORNER RECORDATION CERTIFICATE
Filing Requirement of Act 74, Mich. P.A. 1970

96-71

For corners in
IOSCO COMMISSION

Located In:

Corner Code #

(County)

1. Public Land Survey

T23NR9E

NO. 7

G-1 to G-2

T R

T R

T R

2. Property Controlling
in Section

S

T R

S

T R

3. Miscellaneous
Property in Sec.

S

T R

S

T R

4. Lot No. , Recorded Plat

5. Private Claims

STATE OF MICHIGAN
IOSCO COUNTY
FILED

6 DEC 96 2:11 P.M.

BONITA M. COYLE
REGISTER OF DEEDS

Register of Deeds Stamp & File Number

I, WILLIAM E. WOODS, in a field survey on NOV. 19, 1996 do hereby state that under requirements of P.A. 74, Michigan P.A. of 1970, the corner points mentioned in lines 1 and 2 above were in conformance with regulations and rules therefore as required in the current manual of survey instructions of the United States Department of the Interior, Bureau of Land Management or by a decree of a Court of Law and /or that the corner points mentioned in lines 3, 4 and 5 above were in conformance with the rules of the Michigan Board of Land Surveyors or by a Decree of a Court of Law; established, re-established, monumented, recovered, found as expressed below:

NOTE: Not more than 2 corners, all in the same town and range, may be recorded on this certificate.

	A	B	C	D	E	F	G	H	I	J	K	L	M
1													
2	6		5		4		3		2		1		
3													
4	7		8		9		10		11		12		
5													
6	18		17		16		15		14		13		
7													
8	19		20		21		22		23		24		
9													
10	30		29		28		27		26		25		
11													
12	31		32		33		34		35		36		
13													

A. Description of original monument and accessories and/or subsequent restoration:

1843: ORIGINAL GOVERNMENT NOTES

SET POST 68.82 OVER RIVER SABLE.
SET POST RIGHT BANK 12" PINE N08°W, 73
LINKS.

B. Description of corner evidence found and/or method applied in restoring or reestablishing corner:

1996: WILLIAM E. WOODS


SET MEANDER CORNER AT 4572.43 NORTH OF
G-3.

ACCEPTED BY THE IOSCO COUNTY
SURVEY PEER GROUP AS THE
OFFICIAL CORNER UNDER P.A.
345 OF 1990 AT A MEETING
HELD ON 10-23-96

Jane H. Kranger

C. Description of monument for corner and accessories established to perpetuate locating the position of the corner:

5/8 ROD WITH ALUMINUM CAP
10.0 SOUTH TO BAYOU
MEANDER CORNER 197.93 SOUTH
4" WHITE PINE S04°E 9.05
12" OAK N75°W 71.18
6" ASH N64°E 23.16

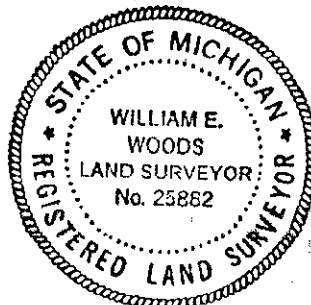

Signed by William E Woods

Date NOVEMBER 19, 1996

Surveyor's Michigan License No. 25882