

SURVEY &
REMONUMENTATION

MAY 07 1997

COMMISSION

IOSCO COUNTY REMONUMENTATION
LAND CORNER RECORDATION CERTIFICATE
Filing Requirement of Act 74, Mich. P.A. 1970

96-81

For corners in

IOSCO

(County)

Located In:

Corner Code #

No. 15

E-3 to E-2

1. Public Land Survey

T 23 R 9

T R

T R

T R

2. Property Controlling
in Section

S

T R

S

T R

3. Miscellaneous
Property in Sec.

S

T R

S

T R

STATE OF MICHIGAN
IOSCO COUNTY
FILED

6 DEC 96 2:13 P.M.

BONITA M. COYLE
REGISTER OF DEEDS

Register of Deeds Stamp & File Number

4. Lot No. , Recorded Plat

5. Private Claims

I, WILLIAM E. WOODS, in a field survey on NOV. 19, 1996 do hereby state that under requirements of P.A. 74, Michigan P.A. of 1970, the corner points mentioned in lines 1 and 2 above were in conformance with regulations and rules therefore as required in the current manual of survey instructions of the United States Department of the Interior, Bureau of Land Management or by a decree of a Court of Law and/or that the corner points mentioned in lines 3, 4 and 5 above were in conformance with the rules of the Michigan Board of Land Surveyors or by a Decree of a Court of Law; established, re-established, monumented, recovered, found as expressed below:

NOTE: Not more than 2 corners, all in the same town and range, may be recorded on this certificate.

A. Description of original monument and accessories and/or subsequent restoration:

1843: ORIGINAL GOVERNMENT SURVEY

40.28 INTERSECT NORTH LINE OF PRIVATE CLAIM. SPRUCE PINE 10" N84°E 231 LINKS NO OTHER TREES CONVENIENT.

B. Description of corner evidence found and/or method applied in restoring or reestablishing corner:

1996: WILLIAM E. WOODS

ESTABLISHED NORTH LINE OF CLAIM USING CLAIM SECTION LINE WIDTH 1815.59 NORTH OF SOUTH CLAIM LINE, AT 2678.45 NORTH OF CORNER E-3.

ACCEPTED BY THE IOSCO COUNTY
SURVEY PEER GROUP AS THE
OFFICIAL CORNER UNDER P.A.
345 OF 1990 AT A MEETING
HELD ON 10-23-96

James H. Shroyer

C. Description of monument for corner and accessories established to perpetuate locating the position of the corner:

5/8 ROD WITH ALUMINUM CAP

10" J. PINE N22°W 10.89


8" J. PINE N58°E 33.45

5" J. PINE N82°E 23.63

8" J. PINE S24°W 11.80

Signed by William E Woods

Surveyor's Michigan License No. 25882

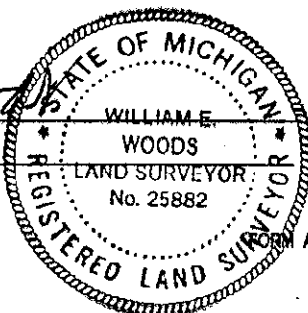

Date NOVEMBER 19, 1996

APPROVED BY MICHIGAN STATE BOARD OF PROFESSIONAL SURVEYORS, JAN. 28, 1971
REVISED MAY 14, 1975
REVISED JAN., 1983
REVISED OCT., 1995