

LAND CORNER RECORDATION CERTIFICATE

Filing Requirement of Act 74, Mich. PA 1970

For Corners In:

Iosco

Located In

Corner Code #

(County)

1. Public Land Survey	T	24N	R	8E	I-5
	T				
2. Property Controlling in Section	S	11	T	24N	R
	S		T		R
3. Miscellaneous Property in Section	S		T		R
	S		T		R


Register of Deeds Stamp & File Number

4. Lot No: _____ Recorded Plat: _____

5. Private Claims: _____

I, Carl T. Kiiskila, in a field survey on December 18, 2006 do hereby state that under requirements of PA 74, Michigan PA of 1970, the corner points mentioned in lines 1 and 2 above were in conformance with regulations and rules therefore as required in the current manual of survey instructions of the United States Department of the Interior, Bureau of Land Management or by a decree of a Court of Law and/or that the corner points mentioned in lines 3, 4 and 5 above were in conformance with the rules of the Michigan Board of Land Surveyors or by a Decree of a Court of Law; established, re-established, monumented, recovered, found as expressed below:

NOTE: Not more than 2 corners, all in the same town and range, may be recorded on this certificate.

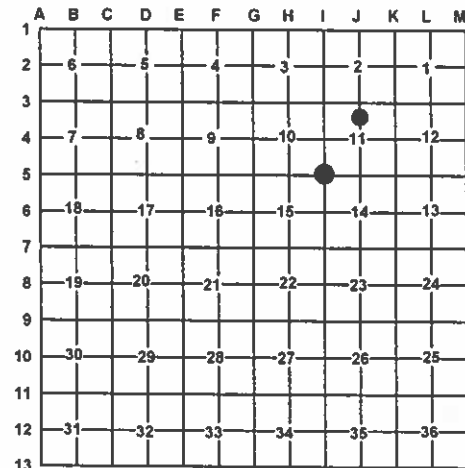

A. Description of original monument and accessories and/or subsequent restoration:

I-5 G.L.O. J. Mullett and Wm. Burt 1843 set post corner sections 10,11,14, and 15

Wit: Spruce Pine 6" S52°E 27 links
Spruce Pine 6" N21°E 40 links

5- This corner position was not established during the original government survey.

Circa 1930 G.F. DeLaMater R.L.S. #693 set a 4" Pipe with a brass cap for corner

1947 Consumers Power Company R.O.W. Map shows monument for corner

1964 Michigan Consolidated Gas R.O.W. map shows monument for corner.

B. Description of corner evidence found and/or method applies in restoring or re-establishing corner:

I-5 Found a 4" pipe filled with concrete and brass cap laying on the ground near the vicinity of the southeast corner of section 11.

5- Established the Northwest corner of the Southwest quarter of the Northeast quarter of section 11 as per B.L.M. instructions for the subdivision of a section.

Re-established the Southwest corner of section 11 with the stationing and right of way maps from Consumers Power Company and Michigan Consolidated Gas Company.

C. Description of monument for corner and accessories established to perpetuate locating the position of the corner:

I-5 4" pipe filled with concrete and brass cap.

Wit: P. Pole	S82°E	51.04'
4" J. Pine	N12°E	71.47'
4" J. Pine	N84°W	36.73'
4" Oak	S42°W	13.38'
Carsonite Post	South	10'±

5- Set 5/8" rerod with P.S. cap#33981

Wit: 7" Maple	S65°W	18.13'
8" Oak	N23°W	13.92'
4" Oak	S34°E	8.27'
8" Oak	South	21.67'
Fence	South	18.01'
Carsonite Post	North	1'±

Signed by:

Carl T. Kiiskila

Date:

4-4-07

Surveyor's Michigan License No.:

33981

