

**FEB 21 2001**

**SECTION**

**LAND CORNER RECORDATION CERTIFICATE**  
Filing Requirement of Act 74, Mich. P.A. 1970

COMMENCING YEAR 2000  
RECEIVED FOR RECORD  
IRON COUNTY, MICHIGAN

00 DEC -5 PM12:49

*L.C. Records: L. 8, P. 199*

*Robert A. Goodreau*  
REGISTERED PROFESSIONAL SURVEYOR

For corners in


<u>Iron</u>	Located In:	Corner Code #
(County)		
1. Public Land Survey	T <u>42N</u> R <u>31W</u>	<u>E-5</u>
	T <u>    </u> R <u>    </u>	<u>    </u>
	T <u>    </u> R <u>    </u>	<u>    </u>
	T <u>    </u> R <u>    </u>	<u>    </u>
2. Property Controlling	S <u>    </u> T <u>    </u> R <u>    </u>	<u>    </u>
in Section	S <u>    </u> T <u>    </u> R <u>    </u>	<u>    </u>
3. Miscellaneous	S <u>    </u> T <u>    </u> R <u>    </u>	<u>    </u>
Property in Sec.	S <u>    </u> T <u>    </u> R <u>    </u>	<u>    </u>

**Register of Deeds Stamp & File Number**

4. Lot No.         , Recorded Plat           
5. Private Claims         

I, Robert A. Goodreau in a field survey on March 22, 2000 do hereby state that under requirements of P.A. 74, Michigan P.A. of 1970, the corner points mentioned in lines 1 and 2 above were in conformance with regulations and rules therefore as required in the current manual of survey instructions of the United States Department of the Interior, Bureau of Land Management or by a decree of a Court of Law and/or that the corner points mentioned in lines 3, 4 and 5 above were in conformance with the rules of the Michigan Board of Land Surveyors or by a Decree of a Court of Law; established, re-established, monumented, recovered, found as expressed below:

**NOTE:** Not more than 2 corners, all in the same town and range, may be recorded on this certificate.

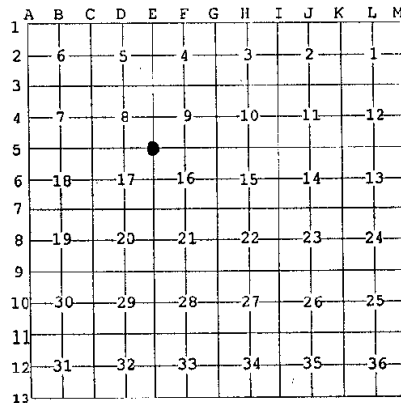

**A. Description of original monument and accessories and/or subsequent restoration:**

E-5 Original corner established by John Burt, U.S. Deputy Surveyor, on 1 August 1849

Original witnesses: Cedar 6 S64W 50 links  
W. Birch 12 N24W 90 links

1" I.D. iron pipe w/ 4" aluminum cap, restored by Keith L. Sackett RLS by double proportion distance from a 1968 survey, on 4 September 1985 (Liber 5, Page 109).

**B. Description of corner evidence found and/or method applied in restoring or reestablishing corner:**

E-5 Found corner as described by Sackett.

Found witnesses recorded as:

9" Cedar	N20E 20.0 ft. S9, NBT
10" Cedar	N24W 17.4 ft. S8, NBT
10" Cedar	S02E 30.9 ft. S16, NBT

Corner record research on file with county representative.

**PEER GROUP APPROVED**  
*Don Ray J. Peck 11-14-2000*  
COUNTY REPRESENTATIVE

**C. Description of monument for corner and accessories established to perpetuate locating the position of the corner:**

E-5 Accepted monument as found.

Witnesses: 10" Cedar N 20° E, 20.6'  
12" Cedar N 20° W, 17.69'  
12" Cedar S 02° E, 31.52'  
11" Cedar S 34° W, 27.52' (NBT)  
Sign post North 1'

Note: Measurements taken to a nail in side of witnesses.

Signed by *RA. G*  
Surveyor's Michigan License No. 43053

Date July 1, 2000

