

**FEB 21 2001**

**SECTION**

**LAND CORNER RECORDATION CERTIFICATE**  
Filing Requirement of Act 74, Mich. P.A. 1970

COMMENCING YEAR 2000  
RECEIVED FOR RECORD  
IRON COUNTY, MICHIGAN

00 DEC -5 PM 12:49

L.C. Record 11.8, P. 206

*Robert A. Goodreau*  
REGISTERED PROFESSIONAL SURVEYOR

For corners in


Iron	Located In:	Corner Code #
(County)		
1. Public Land Survey	T 42N R 31W	G-5
	T R	
	T R	
	T R	
2. Property Controlling In Section	S T R	
	S T R	
3. Miscellaneous Property in Sec.	S T R	
	S T R	

Register of Deeds Stamp & File Number

4. Lot No. \_\_\_\_\_, Recorded Plat \_\_\_\_\_  
5. Private Claims \_\_\_\_\_

I, Robert A. Goodreau in a field survey on May 9, 2000 do hereby state that under requirements of P.A. 74, Michigan P.A. of 1970, the corner points mentioned in lines 1 and 2 above were in conformance with regulations and rules therefore as required in the current manual of survey instructions of the United States Department of the Interior, Bureau of Land Management or by a decree of a Court of Law and /or that the corner points mentioned in lines 3, 4 and 5 above were in conformance with the rules of the Michigan Board of Land Surveyors or by a Decree of a Court of Law; established, re-established, monumented, recovered, found as expressed below:

**NOTE:** Not more than 2 corners, all in the same town and range, may be recorded on this certificate.

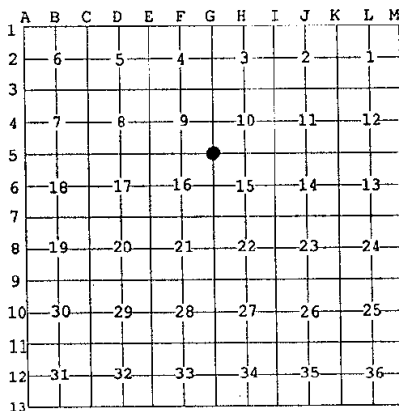

**A. Description of original monument and accessories and/or subsequent restoration:**

G-5 Original corner established by John Burt, U.S. Deputy Surveyor, on 7 August 1849

Original witnesses: W. Birch 8 N30W 35 links  
Spruce 8 S24E 45 links

**B. Description of corner evidence found and/or method applied in restoring or reestablishing corner:**

G-5 Found 3" x 3" Wisconsin and Michigan Power Company monument as described by Frank J. Bray RLS on 18 December 1967 (Liber 2, Page 518).

Found witnesses recorded as: 9" Spruce (S.15)(N.B.T.) S 49° E, 70 links  
7" Spruce (S.9)(N.B.T.) N 74° W, 45.5 links  
12" Spruce (S.10)(N.B.T.) N 34° E, 35.5 links  
1" iron pipe along side of monument

Corner record research on file with county representative.

**PEER GROUP APPROVED**  
*Robert A. Goodreau 11-14-2000*  
COUNTY REPRESENTATIVE

**C. Description of monument for corner and accessories established to perpetuate locating the position of the corner:**

G-5 Accepted monument as found.

Witnesses: 14" spruce S 46° E, 46.42'  
10" spruce N 70° W, 30.26'  
14" spruce N 40° E, 24.15'  
8" spruce S 12° E, 22.12' (NBT)  
1" ID iron pipe Southwest 1'  
Sign post North 1'  
Note: shoreline of lake 25'± West

Note: Measurements taken to a nail in side of witnesses.

Signed by *Robert A. Goodreau*  
Surveyor's Michigan License No. 43053

Date July 1, 2000

