

MAR 9 2000

SECTION

LAND CORNER RECORDATION CERTIFICATE
Filing Requirement of Act 74, Mich. P.A. 1970

For corners in

Form with fields for County (Iron), Located In (T 43N R 34W), Corner Code # (B-13), and numbered sections 1-5 for Public Land Survey, Property Controlling, Miscellaneous, Lot No., and Private Claims.

IRON COUNTY MICHIGAN RECEIVED FOR RECORD stamp with date 99 DEC 30 AM 10:26, handwritten signature, and Register of Deeds Stamp & File Number.

4. Lot No. , Recorded Plat
5. Private Claims

Quarter Corner to Section 31, T43N, R34W
Quarter Corner to Section 6, T42N, R34W

I, Gary L. Pisoni, in a field survey on Oct. 1, 1999 do hereby state that under requirements of P.A. 74, Michigan P.A. of 1970, the corner points mentioned in lines 1 and 2 above were in conformance with regulations and rules therefore as required in the current manual of survey instructions of the United States Department of the Interior, Bureau of Land Management or by a decree of a Court of Law and /or that the corner points mentioned in lines 3, 4 and 5 above were in conformance with the rules of the Michigan Board of Land Surveyors or by a Decree of a Court of Law; established, re-established, monumented, recovered, found as expressed below:

NOTE: Not more than 2 corners, all in the same town and range, may be recorded on this certificate.

Grid table with columns A-M and rows 1-13, containing numerical data points.

A. Description of original monument and accessories and/or subsequent restoration:

Original corner established on September 8, 1846 by William A. Burt, U.S. Deputy Surveyor. Original Corner; Fir Post. Original Bearing Trees: Yellow Birch 16" N 29° E 35 lks (23.10 feet), Yellow Birch 12" N 49° W 32 lks (21.12 feet)


PEER GROUP APPROVED Iron County Representative 12-21-99

B. Description of corner evidence found and/or method applied in restoring or reestablishing corner:

No evidence of original B.T.s found. Found a 1" diameter iron pin located 8' North of the centerline of an existing road known as Lover's Lane which runs East and West. Iron pin was set by local mining company. Iron pin is consistent with GLO distances East and West. I accept the iron pin as the best available evidence for restoring the corner position. Corner record research on file with County Representative.

C. Description of monument for corner and accessories established to perpetuate locating the position of the corner:

Set two (2) reference monuments being a 5/8" diameter by 30" long rebar pin with a 3" diameter aluminum cap stamped as follows: Iron County Remonumentation, T43N, R34W, R.M., 1/4, S-31, S-6, T42N, N 45°W, 47.45 feet, 1999, RLS 27457; T43N, R34W, R.M., 1/4, S-31, S-6, T42N, South, 18.40 feet, 1999, RLS 27457 from which I established the following new blazed and scribed bearing trees or reference objects: Popple 7" N 44° E 47.00 feet, R.M. 5/8"x30" rebar S 45° E 47.45 feet, Red Pine 11" S 37° W 58.46 feet, R.M. 5/8" x 30" rebar North 18.40 feet, Steel sign post North 19.15 feet

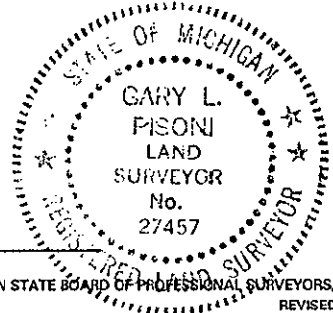

99-93 Signed by Gary L. Pisoni Date 12-28-99 Surveyor's Michigan License No. 27457