

MAR 19 2000

SECTION

LAND CORNER RECORDATION CERTIFICATE
Filing Requirement of Act 74, Mich. P.A. 1970

For corners in

<u>Iron</u> (County)	Located In:	Corner Code #
1. Public Land Survey	T <u>42N</u> R <u>35W</u>	<u>M-12.13(003)</u>
	T <u>42N</u> R <u>34W</u>	<u>A-12.13(005)</u> ✓
	T _____ R _____	_____
	T _____ R _____	_____
2. Property Controlling in Section	S _____ T _____ R _____	_____
	S _____ T _____ R _____	_____
3. Miscellaneous Property in Sec.	S _____ T _____ R _____	_____
	S _____ T _____ R _____	_____

IRON COUNTY
MICHIGAN
RECEIVED FOR RECORD
99 DEC 30 AM 10:30
L.C. Records: L.S., P. 115
Robert Steljes
REGISTERED DEEDS
Register of Deeds Stamp & File Number

4. Lot No. _____, Recorded Plat _____
5. Private Claims _____

North Meander Corner to Section 36, T42N, R35W
North Meander Corner to Section 31, T42N, R34W

I, Gary L. Pisoni, in a field survey on Oct. 27, 1999 do hereby state that under requirements of P.A. 74, Michigan P.A. of 1970, the corner points mentioned in lines 1 and 2 above were in conformance with regulations and rules therefore as required in the current manual of survey instructions of the United States Department of the Interior, Bureau of Land Management or by a decree of a Court of Law and/or that the corner points mentioned in lines 3, 4 and 5 above were in conformance with the rules of the Michigan Board of Land Surveyors or by a Decree of a Court of Law; established, re-established, monumented, recovered, found as expressed below:

NOTE: Not more than 2 corners, all in the same town and range, may be recorded on this certificate.

	A	B	C	D	E	F	G	H	I	J	K	L	M
1													
2	6		5		4		3		2		1		
3													
4	7		8		9		10		11		12		
5													
6	18		17		16		15		14		13		
7													
8	19		20		21		22		23		24		
9													
10	30		29		28		27		26		25		
11													
12	31		32		33		34		35		36		
13													

A. Description of original monument and accessories and/or subsequent restoration:

Original corner established on August 11, 1851 by Harvey Mellen, U.S. Deputy Surveyor.
Original Corner; Wood Post
Original Bearing Trees:
Cedar 12" N 48° W 51 lks (33.66 feet)
Spruce 14" S 77° W 44 lks (29.04 feet)

PEER GROUP APPROVED
Iron County Rep 12-21-99
COUNTY REPRESENTATIVE


B. Description of corner evidence found and/or method applied in restoring or reestablishing corner:

Restore the corner position at record bearing and distance from the Cedar bearing tree which has been blown over and lying on its side. Monument is located 1 1/2' from river bank.
Corner record research on file with County Representative.

C. Description of monument for corner and accessories established to perpetuate locating the position of the corner:

At the corner position, set a 3/4" diameter aluminum rod monument, 3 feet long and 2" above ground surface with a 3" diameter aluminum cap stamped as follows: Iron County Remonumentation, T42N, R35W, R34W, M.C., S-36, S-31, 1999, RLS 27457 from which I established the following new blazed and scribed bearing trees: (All measurements taken to a nail in side of tree)

Spruce	15"	West	39.47 feet
Spruce	12"	N 38°W	48.97 feet
Ash	7"	N 11° E	82.64 feet
Steel sign post		North	0.90 feet

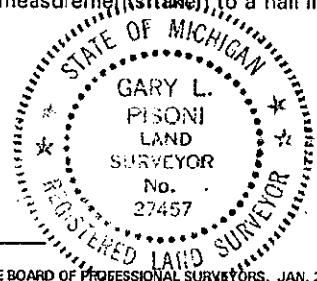

99-115
Signed by Gary L. Pisoni Date 12-28-99
Surveyor's Michigan License No. 27457