

MAR 9 2000

## SECTION

LAND CORNER RECORDATION CERTIFICATE  
Filing Requirement of Act 74, Mich. P.A. 1970

For corners in

Iron  
(County)

Located In:

Corner Code #

1. Public Land Survey

T 43N R 32W

G-8,9

T      R     

(003)

T      R     T      R     2. Property Controlling  
in SectionS      T      R     S      T      R     

3. Miscellaneous

S      T      R     

Property in Sec.

S      T      R     IRON COUNTY  
MICHIGAN  
RECEIVED FOR RECORD

99 DEC 30 AM 10:23

L.C. Records: L. 8, P. 79

*Gilbert L. Pisoni*  
REGISTERED LAND SURVEYOR

Register of Deeds Stamp &amp; File Number

4. Lot No.         , Recorded Plat         5. Private Claims         

North Meander Corner to Sections 21 and 22, T43N, R32W

I, Gary L. Pisoni, in a field survey on Dec. 18, 1999 do hereby state that under requirements of P.A. 74, Michigan P.A. of 1970, the corner points mentioned in lines 1 and 2 above were in conformance with regulations and rules therefore as required in the current manual of survey instructions of the United States Department of the Interior, Bureau of Land Management or by a decree of a Court of Law and/or that the corner points mentioned in lines 3, 4 and 5 above were in conformance with the rules of the Michigan Board of Land Surveyors or by a Decree of a Court of Law; established, re-established, monumented, recovered, found as expressed below:

NOTE: Not more than 2 corners, all in the same town and range, may be recorded on this certificate.

	A	B	C	D	E	F	G	H	I	J	K	L	M
1													
2		6		5		4		3		2		1	
3													
4		7		8		9		10		11		12	
5													
6		18		17		16		15		14		13	
7													
8		19		20		21		22		23		24	
9													
10		30		29		28		27		26		25	
11													
12		31		32		33		34		35		36	
13													

A. Description of original monument and accessories and/or subsequent restoration:

Original corner established on August 6, 1849 by Z. B. Searls, U.S. Deputy Surveyor.

Original Corner; Wood Post

Original Bearing Trees:

White Birch 6" N 85° W 6 lks (3.96 feet)

Yellow Pine 8" N 25° E 9 lks (5.94 feet)

PEER GROUP APPROVED

*Iron County Peer Group 12-21-99*

COUNTY REPRESENTATIVE

B. Description of corner evidence found and/or method applied in restoring or reestablishing corner:

No evidence of original B.T.s found.

Restored the Meander corner position on a fence line located on the North shore of Runkle Lake, said fence line is being used as the Section line between Sections 21 and 22. Meander corner is 17 feet South of the last fence post located on top of a hill and said corner is 12 feet North of the waters edge.

I accept the fence line as the best available evidence for restoring the corner position. Set an aluminum pipe monument which is flush with ground surface.


Corner record research on file with County Representative.

C. Description of monument for corner and accessories established to perpetuate locating the position of the corner:

At the corner position, set a 2" diameter by 30" long split base aluminum pipe monument, with a 3" dia. aluminum cap stamped as follows: Iron County Remonumentation, T43N, R32W, S-21, S-22, M.C. 1999, RLS 27457

from which I established the following new blazed and scribed bearing trees: (All measurements taken to a nail in side of tree)

Red Pine	11"	S 54° W	23.62 feet
Red Pine	13"	S 89° W	13.78 feet
Oak	8" (dbl)	N 29° E	36.47 feet
Steel sign post		North	0.82 feet

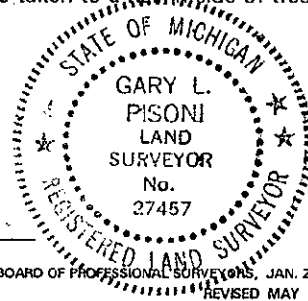

99-79

Signed by *Gary L. Pisoni* Date 12-28-99Surveyor's Michigan License No. 27457

FORM APPROVED BY MICHIGAN STATE BOARD OF PROFESSIONAL SURVEYORS, JAN. 28, 1971  
REVISED MAY 14, 1975  
REVISED JAN., 1983  
REVISED OCT., 1995