

MAR 09 2000

SECTION

LAND CORNER RECORDATION CERTIFICATE
Filing Requirement of Act 74, Mich. P.A. 1970

For corners in

Located In: Iron (County) Corner Code #
1. Public Land Survey T 43N R 35W A-8
T 43N R 36W M-8 ✓
T R
T R
2. Property Controlling S T R
in Section S T R
3. Miscellaneous S T R
Property in Sec. S T R

IRON COUNTY
MICHIGAN
RECEIVED FOR RECORD

99 DEC 30 AM 10:08
L.C. Records: L. 8, P. 3

Eileen J. Pisoni
REGISTERED SURVEYOR

Register of Deeds Stamp & File Number

4. Lot No. , Recorded Plat
5. Private Claims

Quarter Corner between Section 19, T43N, R35W and
Section 24, T43N, R36W

I, Gary L. Pisoni, in a field survey on Dec. 12, 1998 do hereby state that under requirements of P.A. 74, Michigan P.A. of 1970, the corner points mentioned in lines 1 and 2 above were in conformance with regulations and rules therefore as required in the current manual of survey instructions of the United States Department of the Interior, Bureau of Land Management or by a decree of a Court of Law and/or that the corner points mentioned in lines 3, 4 and 5 above were in conformance with the rules of the Michigan Board of Land Surveyors or by a Decree of a Court of Law; established, re-established, monumented, recovered, found as expressed below:

NOTE: Not more than 2 corners, all in the same town and range, may be recorded on this certificate.

	A	B	C	D	E	F	G	H	I	J	K	L	M
1													
2		6		5		4		3		2		1	
3													
4		7		8		9		10		11		12	
5													
6		18		17		16		15		14		13	
7													
8		19		20		21		22		23		24	
9													
10		30		29		28		27		26		25	
11													
12		31		32		33		34		35		36	
13													

A. Description of original monument and accessories and/or subsequent restoration:

Original corner established on September 13, 1846 by John Burt, U.S. Deputy Surveyor. PEER GROUP APPROVED
Original Corner; Yellow Birch Post *Iron County Rep. 8-24-99*
Original Bearing Trees: COUNTY REPRESENTATIVE
Yellow Birch 8" S 70°E 12 lks (7.92 feet)
Yellow Birch 6" N 87°W 13 lks (8.58 feet)

On 10-27-67, Donald Lappala, Cadastral Surveyor, found a 3" X 3" X 56" cedar post at record bearing and distance from the two original bearing trees. Set a 2" inside diameter by 2 foot long concrete filled iron pipe with a 3" circular bronze tablet stamped for corner.

1967 Bearing Trees:

Sugar Maple 7" S 78°E 12.3 feet
Sugar Maple 3" S 05°W 24.5 feet
Sugar Maple 7" S 55°W 4.1 feet

B. Description of corner evidence found and/or method applied in restoring or reestablishing corner:

No evidence of original B.T.s found.

On 12-12-98 Found existing brass cap lying on its side, on 3/2/99 reset the corner position with an aluminum pipe monument from the existing bearing trees:

Sugar Maple 13" S 76°E 12.14 feet
Sugar Maple 7" S 06°W 24.47 feet
Sugar Maple 12" S 54°W 4.18 feet

Corner record research on file with county representative.

C. Description of monument for corner and accessories established to perpetuate locating the position of the corner:

From the above described corner position, I set a 2" diameter by 18" long split base aluminum pipe monument, with a 3" aluminum cap stamped as follows: Iron County Remonumentation, T43N, R36W, R35W, 1/4, S-24, S-19, 1999, RLS 27457, from which I blazed and scribed the following new bearing tree: (All measurements taken to 18" inside of tree)

Hemlock 18" N 48°W 17.23 feet
Steel sign post S 10°E 5.34 feet


99-03

Signed by *Gary L. Pisoni*

Date 12-28-99

Surveyor's Michigan License No. 27457

FORM APPROVED BY MICHIGAN STATE BOARD OF PROFESSIONAL SURVEYORS, JAN 28, 1971
REVISED MAR 14, 1975
REVISED JAN., 1983
REVISED OCT., 1995

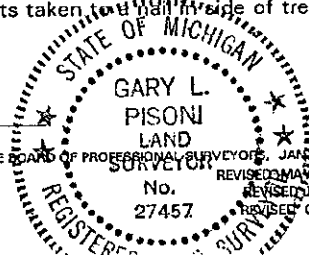

LIBER

8 PAGE

3