

SURVEY & REMONUMENTATION

FEB 21 2001

SECTION

LAND CORNER RECORDATION CERTIFICATE Filing Requirement of Act 74, Mich. P.A. 1970

For corners in

<u>Iron</u>	Located In:	Corner Code #
(County)		
1. Public Land Survey	T 43N R 36W	A-1
	T 44N R 36W	A-13
	T 43N R 37W	M-13
	T 44N R 37W	M-13
2. Property Controlling	S T R	
in Section	S T R	
3. Miscellaneous	S T R	
Property in Sec.	S T R	

4. Lot No. _____, Recorded Plat _____
5. Private Claims _____

I, Robert A. Goodreau in a field survey on May 10, 2000 do hereby state that under requirements of P.A. 74, Michigan P.A. of 1970, the corner points mentioned in lines 1 and 2 above were in conformance with regulations and rules therefore as required in the current manual of survey instructions of the United States Department of the Interior, Bureau of Land Management or by a decree of a Court of Law and/or that the corner points mentioned in lines 3, 4 and 5 above were in conformance with the rules of the Michigan Board of Land Surveyors or by a Decree of a Court of Law; established, re-established, monumented, recovered, found as expressed below:

NOTE: Not more than 2 corners, all in the same town and range, may be recorded on this certificate.

A. Description of original monument and accessories and/or subsequent restoration:

Original corner established by Austin Burt, U.S. Deputy Surveyor, in 1847.

Original witnesses: Lynn 14" S 20° E 8 links
Sugar Maple 12" N 12° W 37 links

Donald D. Lappala RLS restored corner position on 22 September 1964 by marking a cross (x) in pavement using a 1934 Michigan State Highway project plan and existing reference monuments. He also set a 2" x 5' concrete filled iron pipe w/ bronze tablet as a reference monument (Liber 3, Page 283).

B. Description of corner evidence found and/or method applied in restoring or reestablishing corner:

Found iron bar in monument box set by unknown surveyor.

Found witness recorded by Lappala as: 9" Sugar Maple S 44° W 75.5' (114.4 links)

Found witness used by unknown surveyor: 7" Maple S 28° E 74.64'

Lappala reference monument destroyed.

Corner record research on file with county representative.

C. Description of monument for corner and accessories established to perpetuate locating the position of the corner:

Accepted corner as found.

Witnesses: 14" Maple S 48° W 74.75' (USFS BT sign)
8" Maple N 54° E 95.51' (NBT)
7" Maple S 28° E 74.64'
10" Maple N 38° W 74.30' (NBT)
Reference monument (iron pipe w/ cap, PS 43053) South 52.9'
Sign post 1' South of reference monument

Note: Measurements taken to a nail in side of witnesses.

Signed by R. A. Goodreau
Surveyor's Michigan License No. 43053

Date July 1, 2000


COMMENCING YEAR 2000
RECEIVED FOR RECORD
IRON COUNTY, MICHIGAN

00 DEC -5 PM 12: 50

L.C. Records: L. 8, P. 220

Robert A. Goodreau
REGISTERED SURVEYOR

Register of Deeds Stamp & File Number

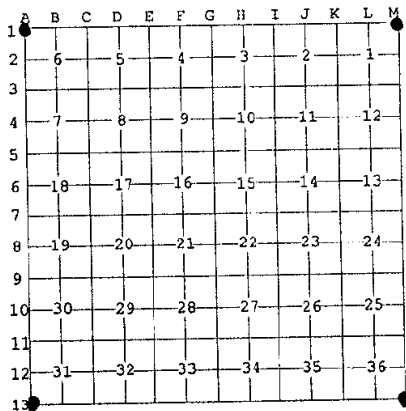

PEER GROUP APPROVED
Don D. Lappala 11-14-2000
COUNTY REPRESENTATIVE

