

LAND CORNER RECORDATION CERTIFICATE  
Filing Requirement of Act 74, Mich. P.A. 1970 as Amended

For corners in

Iron (County)	Located In:	Corner Code #
1. Public Land Survey	T _____ R _____ T _____ R _____ T _____ R _____	_____ _____ _____
2. Property Controlling in Section	S 7 T 45N R 31W S 7 T 45N R 31W S _____ T _____ R _____	15 13 _____
3. Miscellaneous Property in Sec.	S _____ T _____ R _____ S _____ T _____ R _____	_____ _____
4. Lot No. _____, Recorded Plat _____		
5. Private Claims		

Register of Deeds Stamp & File Number

	A	B	C	D	E	F	G	H	I	J	K	L	M
1													
2		6		5		4		3		2		1	
3													
4		7		8		9		10		11		12	
5													
6		18		17		16		15		14		13	
7													
8		19		20		21		22		23		24	
9													
10		30		29		28		27		26		25	
11													
12		31		32		33		34		35		36	
13													

I, Stephan J. Szyszkoski, in a field survey on 13 05/31/2011 do hereby state  
that under requirements of P.A. 74, Michigan P.A. of 1970, the corner points mentioned in lines 1 and 2  
above were in conformance with regulations and rules therefore as required in the current manual of survey  
instructions of the United States Department of the Interior, Bureau of Land Management or by a decree of  
a Court of Law and /or that the corner points mentioned in lines 3, 4 and 5 above were in conformance with  
the rules of the Michigan Board of Land Surveyors or by a Decree of a Court of Law; established, re-established,  
monumented, recovered, found as expressed below:

NOTE: Not more than 2 corners, all in the same town and range, may be recorded  
on this certificate.

A. Description of original monument and accessories and/or subsequent restoration:

(15-Sec. 7) West 1/16 corner between Sections 7 and 18. Not established in the original survey.

(13-Sec. 7) Southeast 1/16 corner, Section 7. Not established in the original survey.

B. Description of corner evidence found and/or method applied in restoring or reestablishing corner:

(15-Sec. 7) Established the corner on the Section line between Section corner 1316.59' west (19.98  
ch. U.S. plat) and Quarter corner 1317.92' east (20.00 ch. U.S. plat), being 20 chains, proportionate  
to the original record, west of the 1/4 corner.

(13-Sec. 7) Established the corner at the intersection of straight lines connecting opposite 1/16  
corners. The corner position was not monumented. Established a witness corner on the East 1/16 line  
470.00' south of the 1/16 corner position, on a straight line between the corner position and the  
monumented 1/16 corner #16, Section 7. The position for the 1/16 corner #13 can be monumented. It  
falls north of the Paint River. I placed this witness monument south of the river to facilitate line  
running for an MDNR timber sale.

C. Description of monument for corner and accessories established to perpetuate locating the position of the corner:


(15) Set 1"IDx32" I.pipe with 4" alum. MDNR cap.  
Set measuring nail with MDNR tag in the side of:  
10" Sugar N21E 9.5' mrkd "1/16S BT"  
8" Sugar S34E 20.5' do  
7" Sugar S30W 14.0' do  
9" Sugar N76W 12.4' do  
Set sq'd Cedar post adjacent.  
Bearings are magnetic.

(13) Set 1"IDx32" I.pipe with 4" alum. MDNR cap  
470.00' south of the corner position and on the  
East 1/16 line for a Witness Corner.  
Set measuring nail with MDNR tag in the side of:  
5" Sugar S29E 1.35' mrkd "WC BT"  
4" Sugar S31W 4.15' do  
8" Sugar N50W 2.3' do  
7" Sugar N03W 7.3' do  
Bearings are magnetic. Set sq'd post adjacent.

Signed by Stephan J. Szyszkoski  
Surveyor's Michigan License No. 33986

Date 08/03/2011

For the Michigan Department of Natural Resources, Forest Management Division

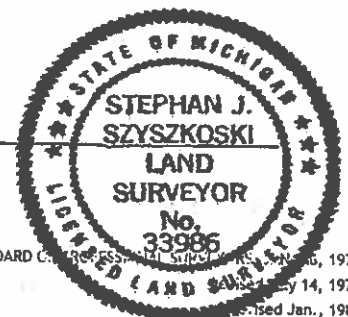

16683

16684