

LAND CORNER RECORDATION CERTIFICATE
Filing Requirement of Act 74, Mich. P.A. 1970

For corners in

Iron

Located In:

Corner Code #

(County)

1. Public Land Survey

T 45N R 32W D13
T 45N R 32W E12

2. Property Controlling
in Section

S T R
S T R
S T R

3. Miscellaneous
Property in Sec.


S T R
S T R
S T R

4. Lot No. _____, Recorded Plat _____
5. Private Claims _____

Sep 25 2003

I, Stephan J. Szyszkoski, in a field survey on 20 do hereby state that under requirements of P.A. 74, Michigan P.A. of 1970, the corner points mentioned in lines 1 and 2 above were in conformance with regulations and rules therefore as required in the current manual of survey instructions of the United States Department of the Interior, Bureau of Land Management or by a decree of a Court of Law and/or that the corner points mentioned in lines 3, 4 and 5 above were in conformance with the rules of the Michigan Board of Land Surveyors or by a Decree of a Court of Law, established, re-established, monumented, recovered, found as expressed below.

NOTE: Not more than 2 corners, all in the same town and range, may be recorded on this certificate.

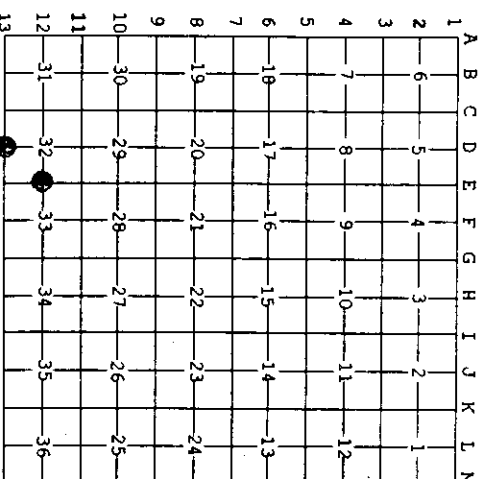

A. Description of original monument and accessories and/or subsequent restoration:


(D13) Quarter corner common to Sections 32 145N-R32W and 5 144N-R32W. Monumented by A.O. Enger from remains of the original 610 bearing trees. Set 1"10x36" I.pipe with 4" aluminum cap. Cedar 14 N49W 33.7', W.Birch 8 S28W 10.3'
(E12) Quarter corner common to Sections 32-33. Corner reestablished midway and on line between Section corners by K.L.Sackett in 1990. Set 1"10x36" I.pipe with 4" aluminum cap. 8" Sugar S85E 10.8', 6" Sugar N16W 2.2', 4" Sugar S15E 23.9'.

B. Description of corner evidence found and/or method applied in restoring or reestablishing corner:

(D13) Recovered the 1971 monument in good condition and at record bearing and distance from the Cedar NBT in good condition with scribing visible, and from the W.Birch NBT, now a rotting stump. Left the monument in place and made new witnesses as described below.
(E12) Recovered the 1990 monument in good condition and at record bearing and distance from the 3 NBTs, all in good condition. The Sugar NW was removed to facilitate GPS observations during this survey. Left the monument in place and made new witnesses as described below.

C. Description of monument for corner and accessories established to perpetuate locating the position of the corner:

(D13) Found 1"10 I.pipe with 4" alum. (E12) Found 1"10 I.pipe with 4" alum.
State of Michigan cap. Blazed, scribed, MDMR cap. Blazed, scribed, and set
and set measuring nails in: measuring nails in:
14" Cedar N53W 33.9' * 9" Sugar S85E 11.2' scribing visible *
8" Spruce N41E 43.7' * 1/4S N8T * 5" Sugar S15E 24.2' overgrown blazes *
6" Y.Birch S76E 22.7' do 20" Sugar S26W 29.9' * 1/4S N8T *
7" Balsam N78W 14.6' do 7" Sugar N65W 16.4' do
Bearings are magnetic. Distances are to Bearings are magnetic. Distances are to
nail with tag. * denotes 1971 NBT. nail with tag. * denotes 1990 NBT.

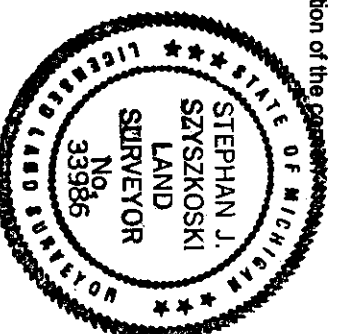

Signed by Stephan J. Szyszkoski
Surveyor's Michigan License No. 33986

Date 9/30/03

Register of Deeds Stamp & File Number