

**LAND CORNER RECORDATION CERTIFICATE**


Authority: 1970 PA 74, MCL 54.205

Surveyor's Name: Stephan J. Szyszkoski

Field Survey Date: September 1, 2016

For corner(s) in: Iron County

Original Public Land Survey Corner		Corner Code
a. S _____	T 46N R 32W	E08 (GCDB 300340)
b. S _____	T 46N R 32W	E07 (GCDB 300400)
S _____	T _____ R _____	_____
S _____	T _____ R _____	_____
Property Corner		1/16 Corner Code
S _____	T _____ R _____	_____
S _____	T _____ R _____	_____
S _____	T _____ R _____	_____
S _____	T _____ R _____	_____

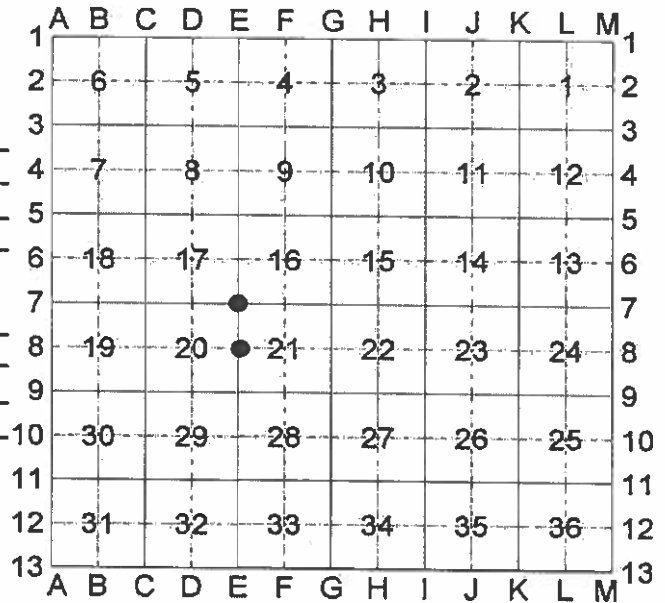

**Part A. Corner History**

a.) Quarter corner common to Sections 20 and 21. 1852 - Established by Francis Houck, U.S. Deputy. Set post midway and on the Section line between Section corners 39.91 ch north and south. Sugar 8" N52°W 20 links, W.Pine 18" S30°E 1 link. Found no subsequent record.

b.) Corner common to Sections 16-17-20-21. 1852 - Established by Francis Houck, U.S. Deputy, monument presumed to be a post. Sugar 14" N49°E 28 links, Sugar 12" S41°W 48 links. Found no subsequent record.

**Part B: Surveyor's Report on Perpetuation, Restoration, Reestablishment, or Monumentation of Corner**

a.) The original post and accessories were not recovered. Found no evidence of the position of the original corner on the ground. Reestablished the position for the corner midway and on the Section line between Section corners 2631.56' north and south.

b.) The original post and accessories were not recovered. Found no evidence of the position of the original corner on the ground. Reestablished the position for the corner by double proportionate measurement to the original record between corners E05 5275.02' (80.00 ch. R) north; F07 2627.46' (40.00 ch. R) east; E13 15789.35' (239.46 ch. R) south; and D07 2627.48' (40.00 ch. R) west.

**Part C: Field Evidence of Perpetuation or Monumentation of Corner**

a.) Set 1"IDx28" I.pipe with 2" alum. MDNR cap. Set measuring nail with MDNR tag in the side of:  
 12" Sugar N24°E 6.3' mrkd "1/4S NBT"  
 10" Sugar S74°E 23.3' do  
 4" Sugar S17°W 10.55' do  
 4" Sugar N64°W 14.5' do  
 Set sq'd cedar post adjacent.  
 E= 7898019.675 N= 177137.510

b.) Set 1"IDx28" I.pipe with 2" alum. MDNR cap. Set measuring nail with MDNR tag in the side of:  
 5" Sugar N88°E 12.15' mrkd "S16 NBT"  
 8" Sugar S70°E 13.15' "S21 NBT"  
 9" Sugar S54°W 17.4' "S20 NBT"  
 12" Sugar N80°W 4.95' "S17 NBT"  
 Set sq'd cedar post adjacent.  
 E= 7898032.681 N= 177939.363

Bearings are magnetic. Coordinates are MCS83, NAD83(2011) Epoch 2010.00, in meters. Coordinate Reference: MDNR Network control "BONE", a 1"ID I.pipe with 2" alum cap., E= 7899059.778 m. N= 176329.657 m.

Stephan J. Szyszkoski 10/13/2016

