

LAND CORNER RECORDATION CERTIFICATE

Authority: 1970 PA 74, MCL 54.205

Surveyor's Name: Stephan J. Szyszkoski

Field Survey Date: August 31, 2016

For corner(s) in: Iron County

Original Public Land Survey Corner


Corner Code

a. S T 46N R 32W I07 (GCDB 500400)
b. S T 46N R 32W G05 (GCDB 400500)
S T R
S T R

Property Corner

1/16 Corner Code

S T R
S T R
S T R
S T R

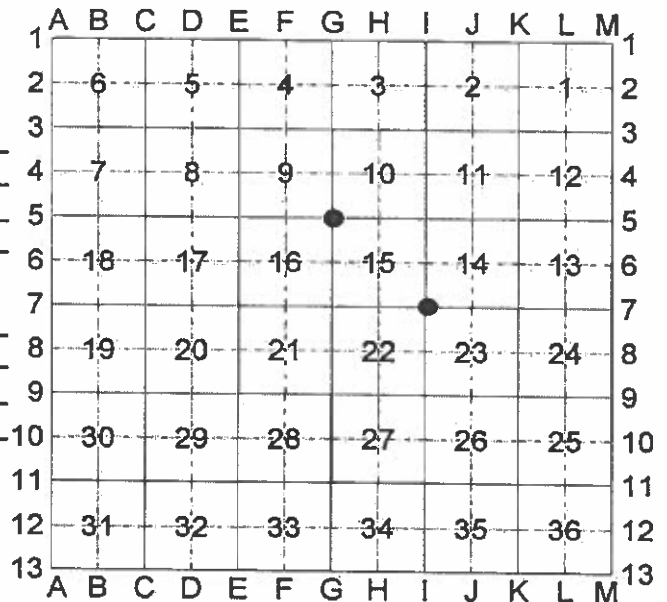

Part A. Corner History

a.) Corner common to Sections 14-15-22-23. 1852 - Established by Francis Houck, U.S. Deputy, monument presumed to be a post. BTs - Spruce 10" N76°E 19 links, Tam. 16" S51°W 17 links. Found no subsequent record.

b.) Corner common to Sections 9-10-15-16. 1852 - Established by Francis Houck, U.S. Deputy, monument presumed to be a post. W.Pine 24" N76-1/2°E 39 links, W.Pine 30" S76°W 25 links. Northern Paper Mills records: June 1931 - H.Cole and R.Sillers found W.P. N.E. as a stump. I.M. Jan 1950 - D.Buell and J.Peryam found W.P. N.E. with face, no I.M. Found L.E.S. post N.P.M.L.P. and lines. Dec. 1953 - D.Buell and H.Gerry found W.P. N.E. as a stump with face, no I.M. W.Pine S.W. no trace. Found L.E.S. post, N.P.M.L.P. and lines. Set pipe and brass cap from W.Pine stump, established new B.T.s: W.Pine 8" N77°E 73 links, W.Pine 10" S04°E 70 links.

Part B: Surveyor's Report on Perpetuation, Restoration, Reestablishment, or Monumentation of Corner

a.) The original post and accessories were not recovered. At a position consistent with the original record, I found a old 1"ID iron pipe with nearby blazed trees and an old squared post laying on the ground, adjacent. Accepted the pipe as the best available evidence of the position of the original corner.

b.) Found the 1953 monument in good condition and at record bearing and distance from the 1953 witness W.Pines. The W.P. NE is standing dead with overgrown blazes. The W.P. SE is a rotted stump. A 4"x4" post stands adjacent to the monument. Accepted the monument as a careful and faithful perpetuation of the position of the original corner.

Part C: Field Evidence of Perpetuation or Monumentation of Corner

a.) Found 1"ID I.pipe. Set plastic cap "Mich DNR PS33986" in the top of it. Set measuring nail with MDNR tag in the side of:
9" Tamarack N28°E 10.25' mrkd "S14 NBT"
5" B.Spruce S62°E 5.5' "S23 NBT"
8" Tamarack S23°W 13.0' "S22 NBT"
6" B.Spruce N59°W 4.45' "S15 NBT"
E= 7901245.801 N= 177887.461

b.) Found 1"ID I.pipe with 2" brass NPM cap. Set measuring nail with MDNR tag in the side of:
3" Maple S65°E 18.5' mrkd "S15 NBT"
4" Maple S05°W 4.8' "S16 NBT"
6" Balsam S87°W 15.15' "S16 NBT"
11" Spruce N26°W 10.95' "S9 NBT"
Set sq'd cedar post adjacent.
E= 7899651.002 N= 179522.602

Bearings are magnetic. Coordinates are MCS83, NAD83(2011) Epoch 2010.00, in meters.
Coordinate Reference: MDNR Network control "BONE", a 1"ID I.pipe with 2" alum cap., E= 7899059.778 m. N= 176329.657 m.

Stephan J. Szyszkoski

10/13/2016



Professional Surveyor's License No.: 33986

page 1 of 1

Prepared By: S.J. Szyszkoski for the Michigan Dept. of Natural Resources, 427 N. US41 Baraga, MI 49908