

SURVEY &
REMONUMENTATION

JAN 19 1999

SECTION

LAND CORNER RECORDATION CERTIFICATE
Filing Requirement of Act 74, Mich. P.A. 1970

For corners in

Iron Located In: Corner Code #
(County)

1. Public Land Survey T 46N R 34W C D-11w
T R # 004
T R
T R

2. Property Controlling S T R
in Section S T R

3. Miscellaneous S T R
Property in Sec. S T R

IRON COUNTY
MICHIGAN
RECEIVED FOR RECORD

98 DEC 28 AM 11:28

L.P. Records: L.7, P. 332

Register of Deeds Stamp & File Number

4. Lot No. , Recorded Plat
5. Private Claims

West Meander Corner Sections 29 and 32, T46N R34W

I, Gary L. Pisoni, in a field survey on June 1, 19 98 do hereby state that under requirements of P.A. 74, Michigan P.A. of 1970, the corner points mentioned in lines 1 and 2 above were in conformance with regulations and rules therefore as required in the current manual of survey instructions of the United States Department of the Interior, Bureau of Land Management or by a decree of a Court of Law and /or that the corner points mentioned in lines 3, 4 and 5 above were in conformance with the rules of the Michigan Board of Land Surveyors or by a Decree of a Court of Law; established, re-established, monumented, recovered, found as expressed below:

NOTE: Not more than 2 corners, all in the same town and range, may be recorded on this certificate.

	A	B	C	D	E	F	G	H	I	J	K	L	M
1													
2		6		5		4		3		2		1	
3													
4		7		8		9		10		11		12	
5													
6		13		17		16		15		14		13	
7													
8		19		20		21		22		23		24	
9													
10		30		29		28		27		26		25	
11													
12		31		32		33		34		35		36	
13													

A. Description of original monument and accessories and/or subsequent restoration:

Original corner established by Z.B. Searls, U.S. Deputy Surveyor on July 9, 1852.

Original corner: Wood Post

Original bearing trees:

Cedar	12"	S 29°W	35 links (23.10 feet)
Fir	6"	N 73°W	23 links (15.18 feet)

PEER GROUP APPROVED

Iron Co. Rep. 12-18-98
COUNTY REPRESENTATIVE

B. Description of corner evidence found and/or method applied in restoring or reestablishing corner:

No evidence of original B.T.s found. Restored corner position by single proportionate measurement methods and on line between the East Meander corner located near the quarter corner and the East Meander corner located near the West Sixteenth Corner between Sections 29 and 32.

Corner Record Research on file with County Representative.

C. Description of monument for corner and accessories established to perpetuate locating the position of the corner:

At the corner position, set a 3/4" diameter aluminum rod monument, flush with ground surface 3 feet long with a 3" diameter aluminum cap stamped as follows: Iron County Remonumentation, T46N, R34W, S-29, S-32, M.C., 1998, RLS 27457 from which I established the following new blazed and scribed bearing trees: (All measurements taken to a nail in side of tree)

Red Maple clump	13"	S 34°W	49.40 feet
Spruce	12"	S 64°W	40.12 feet
Balsam	8"	N 68°W	11.93 feet
Rebar	5/8" x 30"	S 89°47' 45"W	8.00 feet
Steel sign post		West	1.25 feet


#98-160

Signed by Gary L. Pisoni

Date 12-21-98

Surveyor's Michigan License No. 27457

FORM APPROVED BY MICHIGAN STATE BOARD OF PROFESSIONAL SURVEYORS/Jan. 28, 1971

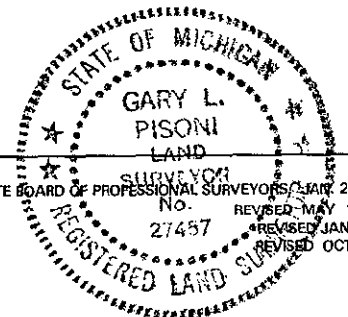

L.7 P.332