

SURVEY &
REMONUMENTATION

FEB 21 2001

SECTION

LAND CORNER RECORDATION CERTIFICATE
Filing Requirement of Act 74, Mich. P.A. 1970

For corners in

IRON

(county)

Located In:

Corner Code#

BATES TOWNSHIP

T 46 N, R 35 W

E-11 (SW SEC. 28)

1. Public Land Survey

2. Property controlling
in Section

3. Miscellaneous
Property in Sec.

S

S

S

S

4. Lot No. _____, Recorded Plat _____

5. Private Claims _____

CORNER COMMON TO SECTIONS 28,29,32,33, T 46 N, R 35 W

I, STEVEN R. APPLEKAMP in a field survey on NOVEMBER 9, 2000 do hereby state that under requirements of P.A. 74, Michigan P.A. of 1970, the corner points mentioned in lines 1 and 2 above were in conformance with regulations and rules therefore as required in the current manual of survey instructions of the United States Department of the Interior, Bureau of Land Management or by decree of a Court of law and/or that the corner points mentioned in lines 3, 4 and 5 above were in conformance with the rules of the Michigan Board of Land Surveyors or by Decree of a Court of Law; established, re-established, monumented, recovered, found as expressed below:

NOTE: Not more than 2 corners, all in the same town and range, may be recorded on this certificate.

A. Description of original monument and accessories and/or subsequent restoration:

ORIGINAL CORNER ESTABLISHED BY HARVEY MELLEN, U.S. DEPUTY SURVEYOR ON JUNE 12, 1851.

ORIGINAL BEARING TREES:

CEDAR	CEDAR
14"	18"
N 42°E	N 88°W
35 LINKS	24 LINKS

B. Description of corner evidence found and/or method applied in restoring or reestablishing corner:

FOUND NO ORIGINAL EVIDENCE, PLACED CORNER AT DOUBLE PROPORTINATE LOCATION FROM ALREADY ESTABLISHED CORNERS ONE MILE EAST AND ONE MILE NORTH, ONE-HALF MILE WEST AND ONE-HALF MILE SOUTH. THE POSITION FELL APPROXIMATELY 80 FEET NORTH OF CREEK (GLO WAS 86 FEET) AND 33 FEET EAST OF CREEK (GLO WAS 39.6 FEET).

C. Description of monument for corner and accessories established to perpetuate locating the position of the corner:

E-11 SET A STAMPED ALUM. IRON COUNTY CAP ON 9 FEET OF MARSH ROD AND MADE THE FOLLOWING NEW BEARING TREES. (ALL MEASUREMENTS TAKEN TO NAIL IN SIDE OF TREE)

BLACK SPRUCE	CEDAR	CEDAR	BLACK SPRUCE	STEEL SIGN
5"	11"	7"	5"	POST
N 53°E	S 47°E	S 21°W	N 38°W	NORTH
25.86'	19.82'	52.25'	9.80'	0.50'


COMMENCING YEAR 2000
RECEIVED FOR RECORD
IRON COUNTY, MICHIGAN

00 DEC -4 AM 10:09

L.C. Records: L. 8, P. 188


Register of Deeds Stamp & File Number

1	A	B	C	D	E	F	G	H	I	J	K	L	M
2	6		5		4		3		2		1		
3													
4	7		8		9		10		11		12		
5													
6	18		17		16		15		14		13		
7													
8	19		20		21		22		23		24		
9													
10	30		29		28		27		26		25		
11													
12	31		32		33		34		35		36		
13													

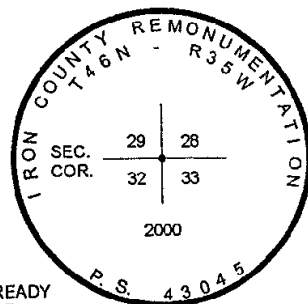

PEER GROUP APPROVED

Dean Gary J. Koon 11-30-2000
COUNTY REPRESENTATIVE

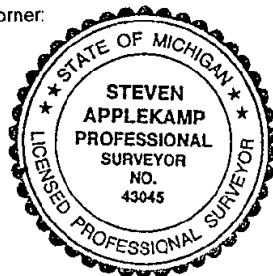

Signed by

Steven R. Applekamp

Date

NOVEMBER 9, 2000

Surveyor's Michigan License No.

43045

LIBER

8 PAGE 188