

SURVEY & REMONUMENTATION

FEB 21 2001

SECTION

LAND CORNER RECORDATION CERTIFICATE Filling Requirement of Act 74, Mich. P.A. 1970

For corners in

IRON

(county)

Located In:

Corner Code#

BATES TOWNSHIP

T 46 N, R 35 W

F-11 (S1/4 SEC.28)

1. Public Land Survey

2. Property controlling

S

in Section

S

3. Miscellaneous

S

Property in Sec.

S

4. Lot No. _____, Recorded Plat _____

5. Private Claims _____

1/4 CORNER COMMON TO SECTIONS 28 AND 33 T 46 N, R 35 W

I, STEVEN R. APPLEKAMP in a field survey on NOVEMBER 9, 2000 do hereby state that under requirements of P.A. 74, Michigan P.A. of 1970, the corner points mentioned in lines 1 and 2 above were in conformance with regulations and rules therefore as required in the current manual of survey instructions of the United States Department of the Interior, Bureau of Land Management or by decree of a Court of law and/or that the corner points mentioned in lines 3, 4 and 5 above were in conformance with the rules of the Michigan Board of Land Surveyors or by Decree of a Court of Law, established, re-established, monumented, recovered, found as expressed below:

NOTE: Not more than 2 corners, all in the same town and range, may be recorded on this certificate.

A. Description of original monument and accessories and/or subsequent restoration:

ORIGINAL CORNER ESTABLISHED BY HARVEY MELLEN, U.S. DEPUTY SURVEYOR ON JUNE 12, 1851.

ORIGINAL BEARING TREES:

MAPLE W-BIRCH
6" 14"
N 19°E S 42°W
19 LINKS 12 LINKS

B. Description of corner evidence found and/or method applied in restoring or reestablishing corner:

FOUND NO ORIGINAL EVIDENCE, PLACED CORNER AT SINGLE PROPORTINATE LOCATION FROM ALREADY ESTABLISHED CORNERS ONE-HALF MILE WEST AND ONE-HALF MILE EAST.

C. Description of monument for corner and accessories established to perpetuate locating the position of the corner:

SET A STAMPED ALUM. CAPPED IRON COUNTY MONUMENT (2" x 36" ALUM. PIPE)
AND MADE THE FOLLOWING NEW BEARING TREES: (ALL MEASUREMENTS TAKEN TO NAIL IN SIDE OF TREE)

BLACK SPRUCE
8"
N 28°E
27.77'

RED PINE
8"
S 14°E
7.24'

CEDAR
13"
S 62°W
55.28'

BLACK SPRUCE
6"
N 57°W
47.63'

STEEL SIGN
POST
NW
0.56'

Signed by

Steven R. Applekamp

Date

NOVEMBER 9, 2000

Surveyor's Michigan License No.

43045

COMMENCING YEAR 2000
RECEIVED FOR RECORD
IRON COUNTY, MICHIGAN


00 DEC -4 AM 10:10

L.C. Records: L. 8, P. 191

Steven R. Applekamp
REGISTERED PROFESSIONAL SURVEYOR

Register of Deeds Stamp & File Number

	A	B	C	D	E	F	G	H	I	J	K	L	M
1													
2													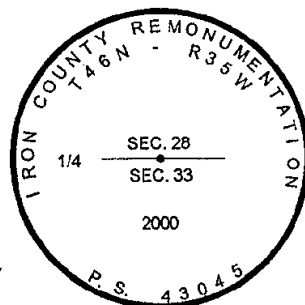
PEER GROUP APPROVED

Peer Group Representative
COUNTY REPRESENTATIVE

