

SURVEY &
REMONUMENTATION

JAN 12 1996

COMMISSION

LAND CORNER RECORDATION CERTIFICATE
Filing Requirement of Act 74, Mich. P.A. 1970

For corners in

Iron
(County)

Located In:

Corner Code #

1. Public Land Survey

T 46N R 37W F, G-11

T R
T R
T R
T R
#001

2. Property Controlling
in Section

S T R

S T R

3. Miscellaneous
Property in Sec.

S T R

S T R

IRON COUNTY
MICHIGAN
RECEIVED FOR RECORD

95 DEC 15 PM 2:22
LC Records L. 6, P. 422

Gilbert J. Pisoni
REGISTER OF DEEDS

Register of Deeds Stamp & File Number

4. Lot No. , Recorded Plat

5. Private Claims

E. Meander Corner 28 & 33 T46N, R37W

I, Gary L. Pisoni, in a field survey on June 15, 1995 do hereby state that under requirements of P.A. 74, Michigan P.A. of 1970, the corner points mentioned in lines 1 and 2 above were in conformance with regulations and rules therefore as required in the current manual of survey instructions of the United States Department of the Interior, Bureau of Land Management or by a decree of a Court of Law and /or that the corner points mentioned in lines 3, 4 and 5 above were in conformance with the rules of the Michigan Board of Land Surveyors or by a Decree of a Court of Law; established, re-established, monumented, recovered, found as expressed below:

NOTE: Not more than 2 corners, all in the same town and range, may be recorded on this certificate.

	A	B	C	D	E	F	G	H	I	J	K	L	M
1													
2	6		5		4		3		2		1		
3													
4	7		8		9		10		11		12		
5													
6	18		17		16		15		14		13		
7													
8	19		20		21		22		23		24		
9													
10	30		29		28		27		26		25		
11													
12	31		32		33		34		35		36		
13													

A. Description of original monument and accessories and/or subsequent restoration:

Original corner established by E.C. Martin, U.S. Deputy Surveyor in 1851.

Original corner: Wood post

Original bearing trees:

Tamarack	12"	N 20°W	23 links (15.18 feet)
Tamarack	18"	S 63°E	30 links (19.80 feet)

Robert Livingston, U.S. Cadastral Engineer in Sept. 1929 recovered original meander corner by a identifying the original corner accessories. He set an 8"dia. by 30" long concrete monument witness meander corner 30 links East of corner position.

B. Description of corner evidence found and/or method applied in restoring or reestablishing corner:

On Sept. 24, 1964, Donald D. Lappala recovered Livingston's 8"x30" concrete monument witness meander corner and established new bearing trees.

B. Description of corner evidence found.

Found Livingston's monument lying at the edge of lake and set a new 2"x 30" long split base aluminum pipe monument with a 3" cast aluminum cap witness corner 35.89 Feet East of original GLO Corner.

ACT 74 Research on file with County Representative


C. Description of monument for corner and accessories established to perpetuate locating the position of the corner:

From the above described aluminum cap monument, I established the following new blazed and scribed bearing trees: (all measurements taken to a nail in side of tree)

White Pine	12"	S 23° E	16.51 feet
Red Pine	16"	N 38° W	10.71 feet
White Pine	10"	N 04° W	12.91 feet
Steel Sign Post		East	0.95 feet

PEER GROUP APPROVED

Gary L. Pisoni
IRON COUNTY, REPRESENTATIVE

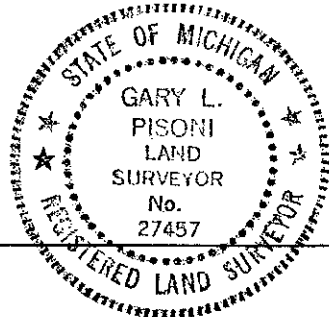

Signed by Gary L. Pisoni
Surveyor's Michigan License No. 27457

Date 11-30-95