

MAR 09 1999

13339

LAND CORNER RECORDATION CERTIFICATE
Filing Requirement of Act 74, Mich. P.A. 1970
Isabella County Remonumentation

SECTION

For corners in

Isabella (County) Located In: Corner Code #
1. Public Land Survey T13 N R 6W G-6
2. Property Controlling in Section S T R
3. Miscellaneous Property in Sec. S T R
4. Lot No. , Recorded Plat
5. Private Claims

9800013339
Filed for Record in
ISABELLA COUNTY, MI
SHARON A BROWN
On 12-30-1998 At 10:28:14 am.
RE LAND COR 9.00
OR Liber 1 Page 256 - 256


Register of Deeds Stamp & File Number

Grid table with columns A-M and rows 2-13. A dot is marked at the intersection of column G and row 6.

I, Timothy E Bebee, in a field survey on November 22, 1998, do hereby state that under requirements of P.A. 74, Michigan P.A. of 1970, the corner points mentioned in lines 1 and 2 above were in conformance with regulations and rules therefore as required in the current manual of survey instructions of the United States Department of the Interior, Bureau of Land Management or by a decree of a Court of Law and/or that the corner points mentioned in lines 3, 4 and 5 above were in conformance with the rules of the Michigan Board of Land Surveyors or by a Decree of a Court of Law; established, re-established, monumented, recovered, found as expressed below:

NOTE: Not more than 2 corners, all in the same town and range, may be recorded on this certificate.

- A. Description of original monument and accessories and/or subsequent restoration:
1837 J. Milroy GLO.....set post
1882 J. Graham CS.....set ironwood stake 3x3
1889 E.R. Coburn CS.....ironwood stake 3x3
1972 A. Courtright LCRC 151.....found 1/2" x 18" steel rod
1987 T. Mueller unrecorded survey.....set 1/2" x 18" bar and cap
1988 W. Tingley LCRC 956.....found 1/2" capped iron

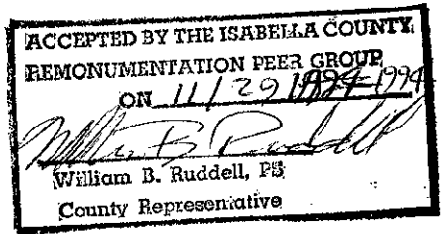

- B. Description of corner evidence found and/or method applied in restoring or reestablishing corner:
Found 1/2" capped iron in paved road 9'± West of centerline Rolland Rd.

- C. Description of monument for corner and accessories established to perpetuate locating the position of the corner:
A Remonumentation monument stamped #17741, placed inside a monument box, was set at the position of the corner and is accepted as the best evidence of the perpetuated corner.

Witnesses:

- N 69° E 64.20' nail & cap in 2" cherry
S 43° E 53.65' nail & cap in 40" maple
S 68° W 53.35' face of 2" well pipe (flowing well)
N 27° W 40.71' nail & cap in 4" sugar maple



Signed by [Signature] Date 12/29/98
Surveyor's Michigan License No. 39074