


10734

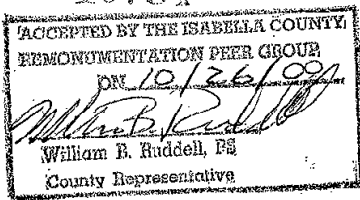

Isabella County Remonumentation Program  
LAND CORNER RECORDATION CERTIFICATE  
Filing Requirement of Act 74, Mich. P.A. 1970

SURVEY &amp; DOCUMENTATION

JAN 19 2001

SECTION

For corners in

ISABELLA Located In: Corner Code  
(County) Sherman Twp.

1. Public Land Survey T. 15N R6W C-1 ✓  
T. 16N R6W C-13  
T. R.  
T. R.  
2. Property Controlling S. T. R.  
in Section S. T. R.  
3. Miscellaneous S. T. R.  
Property in Sec. S. T. R.  
4. Lot No. \_\_\_\_\_, Recorded Plat \_\_\_\_\_  
5. Private Claims \_\_\_\_\_

Instrument Liber Page  
200000010734 1 353  
200000010734  
Filed for Record in  
ISABELLA COUNTY, MI  
SHARON A BROWN  
On 12-08-2000 At 02:33:19 pm.  
RE LAND COR 9.00  
Liber 1 Page 353 - 353

Register of Deeds Stamp &amp; File Number

	A	B	C	D	E	F	G	H	I	J	K	L	M
1													
2	6	5	4	3	2	1							
3													
4	7	8	9	10	11	12							
5													
6	18	17	16	15	14	13							
7													
8	19	20	21	22	23	24							
9													
10	30	29	28	27	26	25							
11													
12	31	32	33	34	35	36							
13													

I, John H. Rauser, P.S., in a field survey on November 1, 2000, do hereby certify that under requirements of P.A. 74, Michigan P.A. of 1970, the corner points mentioned in lines 1 and 2 above were in conformance with regulations and rules therefore as required in the current manual of survey instructions of the United States Department of the Interior, Bureau of Land Management or by a decree of a Court of Law and/or that the corner points mentioned in lines 3, 4 and 5 above were in conformance with the rules of the Michigan Board of Land Surveyors or by a Decree of a Court of Law; established, re-established, monumented, re-monumented, recovered, found as expressed below:

NOTE: Not more than 4 corners, all in the same town and range, may be recorded on this certificate.

## A. Description of original monument and accessories and/or subsequent restoration:

C-1 Section Corner common to Sections 5 & 6, T15N-R6W, Sherman Township, Isabella County  
Corner is common with C-13, T16N-R6W, by original notes of resurvey.

- 1847 GLO wood post found by Arron Lynn, D.S., during resurvey of T15N-R6W, "old corner 27 lks (17.82') West of 5 & 6, held and corrected back. Listed two accessories:  
S43½W 13 lks (8.58") 7" Beech  
S63½E 3 ½ lks (2.31') 7" Beech
- 1974 Certified Survey Act 132, L.001 Pg. 574-575, Set ½" iron rod
- 1974 Act 74 form by Gerald Gray #17741, L.C.R.C. #00325, Set ½" Iron Rod to evidence
- 1981 Certified Survey Act 132, L.003, Pg. 606, Thomas J. Mueller P.S.#25861. Measured 2729.86' to C-2.
- 1988 Act 74 form by William Ruddell #14769, L.C.R.C. #918, Found Solid rod beside stone in line with fence South, S 4.0' Found Re-rod, W 94.42' Found Re-rod
- 1997 Act 74 by Ron Harris #41917, LCRC #1370, found solid shaft, S 4.00' solid rod, W 94.40' fnd. re-rod
- 1997 Witness record from road commission calls for 3/4" iron on N side of large stone, witnessed by N45E 45.95' Nail in utility pole by phone ped, South 61.85' Nail & fence insulator on E-side of 10" post, N60W 47.41' survey tag in south face of fence post.
- 1997 Witness record from road commission calls for found iron rod on N side of large stone (also 3/4 x 3/4 x 9" pointed iron under stone and other iron), witnessed by South 62.00' Nail in electric fence insulator in 9" cedar post in fence row, S30E 63.91' 2x2 tacked hub, N30W 73.29' 2x2 tacked hub. Set ½" rebar using these witnesses.

## B. Description of corner evidence found and/or method applied in restoring or reestablishing corner:

C-1 Section Corner common to Sections 5 & 6, T15N-R6W, Sherman Township, Isabella County  
Corner is existent. Found no evidence of original survey or accessories. Found 5/8"x 12" re-rod (top 4" bent) 15" below grade. Found re-rod appears to have been set by the road commission. Excavated this position as well as 4' South. Found no conflicting evidence. We accept the found re-rod be as the best available evidence of the position of the original government corner.

## C. Description of monument for corner and accessories established to perpetuate locating the position of the corner:

C-1 Section Corner common to Sections 5 & 6, T15N-R6W, Sherman Township, Isabella County  
Set standard Isabella County monument in monument box in centerline of Vernon Road and 4' west of centerline of Sherman Road north, 6" below grade, stamped C-1, #39096.

S55W 38.26' Set traverse point cap on re-rod  
South 23.45' Top centerline East end of CMP  
N20W 52.24' East edge yield sign post  
N60W 76.1' South edge sign post



Signed by John H. Rauser  
Surveyor's Michigan License No. 39096

Date 12/7/00