

LAND CORNER RECORDATION CERTIFICATE

MAR 09 1999

Filing Requirement of Act 74, Mich. P.A. 1970

Isabella County Remonumentation

07318

SECTION

000239

For Corners in  
Isabella

(County)

Located In:

Corner Code#:

1. Public Land Survey T. \_\_\_\_\_ R. \_\_\_\_\_  
T. \_\_\_\_\_ R. \_\_\_\_\_  
T. \_\_\_\_\_ R. \_\_\_\_\_
2. Public Controlling S. 18 T. 16N R. 5W 0001  
in Section S. 17 T. 16N R. 5W 0001
3. Miscellaneous S. \_\_\_\_\_ T. \_\_\_\_\_ R. \_\_\_\_\_  
Property in Section S. \_\_\_\_\_ T. \_\_\_\_\_ R. \_\_\_\_\_
4. Lot No. \_\_\_\_\_, Recorded Plat \_\_\_\_\_
5. Private Claims \_\_\_\_\_

9800007318  
Filed for Record in  
ISABELLA COUNTY, MI  
SHARON A BROWN  
On 07-20-1998 At 03:00:35 pm.  
RE LAND COR 9.00  
OR Liber 1 Page 239 - 239

Register of Deeds Stamp & File Number

I, Mark Robison, in a field survey on July, 1997, do hereby certify that under requirements of P.A. 74, Michigan P.A. of 1970, the corner points mentioned in lines 1 and 2 above were in conformance with regulations and rules therefore as required in the current manual of survey instructions of the United States Department of the Interior, Bureau of Land Management or by a decree of a Court of Law and/or that the corner points mentioned in lines 3, 4 and 5 above were in conformance with the rules of the Michigan Board of Land Surveyors or by a Decree of a Court of Law, established, re-established, monumented, re-monumented, recovered, found as expressed below.

NOTE: Not more than 2 corners, all in the same town and range, may be recorded on this certificate.

A. Description of original monument and accessories and/or subsequent restoration:

1. G.L.O Original Survey  
Township Lines: 2<sup>nd</sup> Quarter 1837 John Hodgson  
Subdivision and Resurvey: 4<sup>th</sup> Quarter 1837 H. Nicholson.  
Page 560 Original Field Notes
2. County Survey Records:  
None
3. L.C.R.C.  
None
4. Surveys of Record

Liber 2, Page 252, Fluaharty Engineering, January 24, 1975, Found 4" wood post, set 5/8" x 18" re-bar & R.L.S. cap

5. Unrecorded Survey  
Paul B. Lapham & Associates, Inc., field notes with witnesses

B. Description of corner evidence found and/or method applied in restoring or re-establishing corner:

This corner established in Isabella County Remonumentation Program. See dossier for detailed report.


Found Cedar stump for meander corner on shoreline 134' (GLO 132) South of East 1/4 Corner, Section 18, T.16N.-R.5W. Post used by Fluaharty in 1975 as meander corner is said East 1/4 Corner in Section 18.

Accepted as best available evidence of the position of the original corner and replaced with Standard Monument Corner.

C. Description of monument for corner and accessories established to perpetuate locating the position of the corner:

Set Standard Isabella County Monument.

N13°E 196.35' Nail & tag in 7" Tamarack  
N43°W 99.78' Nail & tag in 5" Spruce  
N58°W 25.21' Nail & tag in twin Cedar at Lake  
N02°W 134.80' C-6 East 1/4 Corner, Section 18, T.16N.-R.5W.

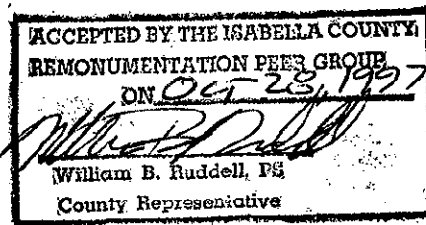

Signed by

*Mark Robison*

Date

05/13/98

Surveyor's Michigan License No. 27458