

LAND CORNER RECORDATION CERTIFICATE
 Filing Requirement of Act 74, Mich. P.A. 1970

For corners in
Jackson
 (County)

Located In: Corner Code #

- 1. Public Land Survey T 4S R 2W
- 2. Property Controlling S _____ T _____ R _____
 in Section S _____ T _____ R _____
- 3. Miscellaneous S _____ T _____ R _____
 Property in Sec. S _____ T _____ R _____

J-1
 SURVEY &
 REMONUMENTATION
 MAY 03 1995
 COMMISSION

STATE OF MICHIGAN
 JACKSON COUNTY
 RECORDED
 30 DEC 94 11:22 A.M.
 GERALD J. McDEVITT
 REGISTER OF DEEDS

Register of Deeds Stamp & File Number

- 4. Lot No. _____, Recorded Plat _____
- 5. Private Claims _____

A	B	C	D	E	F	G	H	I	K	L	M
2	6	5	4	3	2	1					
3											
4	7	8	9	10	11	12					
5											
6	18	17	16	15	14	13					
7											
8	19	20	21	22	23	24					
9											
10	30	29	28	27	26	25					
11											
12	31	32	33	34	35	36					
13											

I, Arden S. Pierson PS in a field survey on December 2, 19 94, do hereby certify that under requirements of P.A. 74, Michigan P.A. of 1970, the corner points mentioned in lines 1 and 2 above were in conformance with regulations and rules therefore as required in the current manual of survey instructions of the United States Department of the Interior, Bureau of Land Management or by a decree of a Court of Law and/or that the corner points mentioned in lines 3, 4 and 5 above were in conformance with the rules of the Michigan Board of Land Surveyors or by a Decree of a Court of Law; established, re-established, monumented, re-monumented, recovered, found as expressed below:

NOTE: Not more than 4 corners, all in the same town and range, may be recorded on this certificate.

- A. Description of original monument and accessories and/or subsequent restoration:
 J-1 - This position not established by original government surveyors.

\$ 2.00 REMONUMENTATION
 \$ 7.00 CORNER REMONUMENTATION


- B. Description of corner evidence found and/or method applied in restoring or reestablishing corner:

Section 2, Hanover Township

J-1 - Set corner on township line, midway between between section corners. This position is accepted as the best available evidence of the position of the corner. Placed Standard Jackson County Monument.

(The position of this corner is set consistent with instructions from the remonumentation surveyor peer group.)

- C. Description of monument for corner and accessories established to perpetuate locating the position of the corner:
J-1 (N 1/4 corner Section 2)
 Jackson County Monument

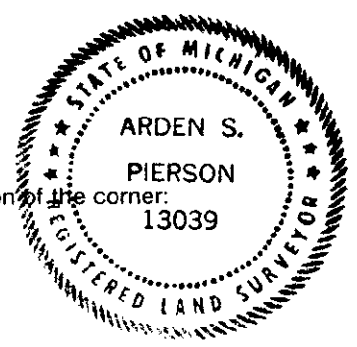

Witness sign post set -South - 1.48'
 (standard corner - West - 142.52')
 Nail & tag #13039 S. side 19" Oak -N55°W- 20.81'
 Nail & tag #13039 W. side 14" Cherry -N03°W-10.46'
 Nail & tag #13039 S. side 7" Elm -N85°E-7.37'
 Nail & tag #13039 S. side 26 Cherry -S74°E- 16.19'

*Standard Jackson County Monument is a 1/2" iron rod 36" long with a Jackson County Remonumentation disk encased in a 4" concrete cylinder.
 December 6, 1994

Signed by Arden S. Pierson Date _____

Surveyor's Michigan License No. 13039