

LAND CORNER RECORDATION CERTIFICATE

Filing Requirement of Act 74, Mich. PA 1970

For Corners In:
Kalkaska
(County)

Located In

Corner Code #

1. Public Land Survey T _____ R _____
2. Property Controlling in Section T 25N R 7W 4
S 24 T 25N R 7W CENW 1/64
3. Miscellaneous Property in Section S _____ T _____ R _____
S _____ T _____ R _____


4. Lot No: _____ Recorded Plat: _____

5. Private Claims: _____

I, Craig W. McVean, in a field survey on March 23, 2004 do hereby state that under requirements of PA 74, Michigan PA of 1970, the corner points mentioned in lines 1 and 2 above were in conformance with regulations and rules therefore as required in the current manual of survey instructions of the United States Department of the Interior, Bureau of Land Management or by a decree of a Court of Law and/or that the corner points mentioned in lines 3, 4 and 5 above were in conformance with the rules of the Michigan Board of Land Surveyors or by a Decree of a Court of Law; established, re-established, monumented, recovered, found as expressed below:

NOTE: Not more than 2 corners, all in the same town and range, may be recorded on this certificate.

Register of Deeds Stamp & File Number

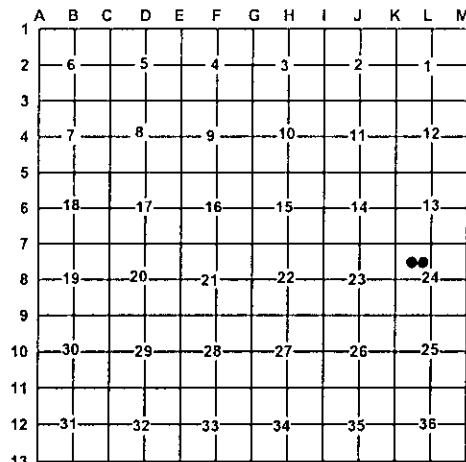

A. Description of original monument and accessories and/or subsequent restoration:

4 - None CENW 1/64 - None



B. Description of corner evidence found and/or method applied in restoring or re-establishing corner:

4 - NW 1/16 Cor. Sec. 24 - Set 2" Alum. Cap on 5/8" x 34" iron rebar per standard BLM procedure. CENW 1/64 - being the SW Cor. of the E 1/2 of NE 1/4 of NW 1/4 Sec. 24 - Set 2" Alum. Cap on 5/8" x 34" iron rebar per Standard BLM procedure.

C. Description of monument for corner and accessories established to perpetuate locating the position of the corner:

4 - Stamped 2" Alum. Cap on 5/8" x 34" iron rebar N30°E 16.96' to set N & T in NW side 6" Cedar S77°E 9.55' to set N & T in N. side 9" R. Maple S6°W 28.85' to set N & T in W. side 21" R. Pine S77°W 21.81' to set N & T in S. side 10" Cedar Set blue carbonite post w/ loc. tag 1' SW CENW 1/64 - Stamped 2" Alum. Cap on 5/8" x 34" iron rebar West 10.38' to set N & T in N. side 9" R. Pine N9°W 12.64' to set N & T in W. side 20" R. Pine S3°E 9.41' to set N & T in W. side 7" R. Pine S61°E 8.24' to set N & T in SW side Tw. 7" W. Pine Set blue carbonite post w/ loc tag 1' SE

Signed by:

Craig W. McVean

Date:

8/3/2004

Surveyor's Michigan License No.: 39088