

LAND CORNER RECORDATION CERTIFICATE
Filing Requirement of Act 74, Mich. P.A. 1970

For corners in

KALKASKA
(County)

Located In:

Corner Code #

1998 REMONUMENTATION

1. Public Land Survey

T. 26N R. 8W

G-13

T. 25N R. 8W

G-1

T. R.

T. R.

2. Property Controlling
in Section

S. T. R.

S. T. R.

3. Miscellaneous
Property in Sec.

S. T. R.

S. T. R.

SURVEY &
REMONUMENTATION

FEB 22 1999

SECTION

Register of Deeds Stamp & File Number

4. Lot No. , Recorded Plat

5. Private Claims

I, EUGENE FARRIER, in a field survey on November 2, 1998 do hereby state that under requirements of P.A. 74, Michigan P.A. of 1970, the corner points mentioned in lines 1 and 2 above were in conformance with regulations and rules therefore as required in the current manual of survey instructions of the United States Department of the Interior, Bureau of Land Management or by a decree of a Court of Law and /or that the corner points mentioned in lines 3, 4 and 5 above were in conformance with the rules of the Michigan Board of Land Surveyors or by a Decree of a Court of Law; established, re-established, monumented, recovered, found as expressed below:

NOTE: Not more than 2 corners, all in the same town and range, may be recorded on this certificate.

	A	B	C	D	E	F	G	H	I	J	K	L
1												
2	6		5		4		3		2		1	
3												
4	7		8		9		10		11		12	
5												
6	18		17		16		15		14		13	
7												
8	19		20		21		22		23		24	
9												
10	30		29		28		27		26		25	
11												
12	31		32		33		34		35		36	
13												

A. Description of original monument and accessories and/or subsequent restoration:

G-13: Sec. Cor. Common to Secs. 33 & 34, T26N-R8W, Boardman Township, & G-1:

Secs. 3 & 4, T25N-R8W.

1852, G.L.O. Twp. Line Resurvey by V.W. Cankin D.S.; set post of corner; Hemlock 24", N41°E, 26 Lk. (17.16'); Beech 6", N41°W, 22 Lk. (14.52').

1852, G.L.O. Sub. of Twp. T25N-R8W; by V.W. Cankin D.S.; found corner post; Sugar 10", S10°E, 41 Lk. (27.06'); Hemlock 16", S47°W, 35 Lk. (23.10').

1881, Road Survey by E. Mosher CS., Co. Survey Bk. Pg. 86; found corner.

1901, Sec. Sub. Survey by W.S. Merrill CS., Co. Survey Bk. Pg. 4 & 29, set iron stake at corner, located from one Gov't bearing tree.

1-30-74, J. Fletcher, fd. 1 1/2" iron pipe, LCRC in Liber 1, Pg. 291

1-30-74, J. Fletcher, shows cor. only Liber 1, Pg. 465, Cert. of Survey

11-17-81, N. DeYoung, fd. 1" iron pipe, Cert. of Survey

B. Description of corner evidence found and/or method applied in restoring or reestablishing corner:

G-13: Sec. Cor. Common to Secs. 33 & 34, T26N-R8W, Boardman Township, & G-1: Secs. 3 & 4, T25N-R8W.

Fd. and accepted 1" iron pipe 4' West of centerline road North & drive to South, and in centerline drive to West extended (as recorded in LCRC, Liber 1, Pg. 291 and previous Cert. of Surveys) Added 5/8" X 18" re-bar w/brass cap.

N45°E, 48.15' - Power pole, found nail

No G.L.O. witnesses were found.

Kalkaska County Peer Group accepted the above monument as a careful and faithful perpetuation of the position of the original corner.

Ratified by Peer Group

P.A. 345 - 1990 Kalkaska County

Chairman Eugene Farrier

Date 2-2-99

C. Description of monument for corner and accessories established to perpetuate locating the position of the corner:

G-13: Sec. Cor. Common to Secs. 33 & 34, T26N-R8W, Boardman Township, & G-1: Secs. 3 & 4, T25N-R8W.

Fd. and accepted 1" iron pipe 4' West of centerline road North & drive to South, and in centerline drive to West extended. Added 5/8" X 18" re-bar w/brass cap.

S45°W, 48.46' - power pole, set nail

S76°W, 27.33' - 12" Maple (clump), set nail

N45°E, 48.15', power pole, found nail

N74°E, 43.70' - 12" W. Pine, set nail

Signed by Eugene Farrier
Michigan License No. 24594

Date 2-8-99




3012724

Page: 1 of 1

02/10/1999 09:05A

LB: 5 PG: 379

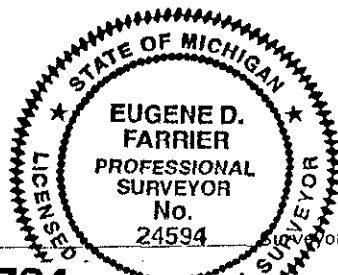

558638 REVISED JAN. 28, 197
REVISED MAY 14, 197
REVISED JAN., 198
REVISED OCT., 198