



8 0 2 3 2 8 2

Tx:4016447

11/29/2012 1:00:00 PM

## LAND CORNER RECORDATION CERTIFICATE

Filing Requirement of Act 74, Mich. PA 1970

For Corners In:

Kalkaska  
(County)

Located In

Corner Code #


1. Public Land Survey	T		R	
	T		R	
2. Property Controlling in Section	S 20	T 26N	R 6W	14
	S 20	T 26N	R 6W	16
3. Miscellaneous Property in Section	S	T	R	
	S	T	R	

4. Lot No: \_\_\_\_\_ Recorded Plat: \_\_\_\_\_

5. Private Claims: \_\_\_\_\_

I, Joshua R. Davidson, in a field survey on February 15, 2012 do hereby state that under requirements of PA 74, Michigan PA of 1970, the corner points mentioned in lines 1 and 2 above were in conformance with regulations and rules therefore as required in the current manual of survey instructions of the United States Department of the Interior, Bureau of Land Management or by a decree of a Court of Law and/or that the corner points mentioned in lines 3, 4 and 5 above were in conformance with the rules of the Michigan Board of Land Surveyors or by a Decree of a Court of Law; established, re-established, monumented, recovered, found as expressed below:

**NOTE: Not more than 2 corners, all in the same town and range, may be recorded on this certificate.**

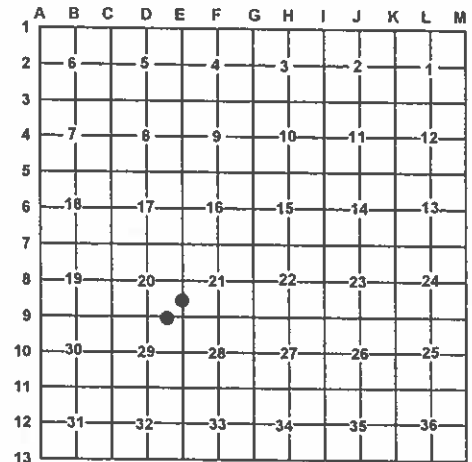

A. Description of original monument and accessories and/or subsequent restoration:

14 - none16 - none

B. Description of corner evidence found and/or method applied in restoring or re-establishing corner:

14 - South 1/16 corner common to sections 20 & 21. Set stamped 2" Aluminum cap on 5/8" x 48" rebar per standard BLM procedure.16 - East 1/16 corner common to Sections 20 & 29. Set stamped 2" Aluminum cap on 5/8" x 48" rebar per standard BLM procedure.

C. Description of monument for corner and accessories established to perpetuate locating the position of the corner:

14 - Set a stamped 2" Aluminum Cap on 5/8" x 48" rebar

East 40.74' to set nail & tag in S. side 17" White Pine  
S02°E 65.92' to set nail & tag in E. side 5" White Pine  
S30°W 44.25' to set nail & tag in SE. side 7" Tamarack  
N07°W 40.68' to set nail & tag in E. side 9" Jack Pine  
Set blue Carsonite post with location tag 1' Northeast

16 - Set a stamped 2" Aluminum Cap on 5/8" x 48" rebar

North 35.28' to set nail & tag in W. side 4" Birch  
N69°E 30.88' to set nail & tag in SE. side 3" Red Maple  
S60°E 5.76' to set nail & tag in S. side 2" Red Maple  
N83°W 15.50' to set nail & tag in N. side 3" Red Maple  
Set blue Carsonite post with location tag 1' North

Signed by:

Date:

11-29-2012

Surveyor's Michigan License No.:

46659