



8 0 2 3 2 7 3

Tx:4016447

11/29/2012 1:00:00 PM

## LAND CORNER RECORDATION CERTIFICATE

Filing Requirement of Act 74, Mich. PA 1970

DOCUMENT #

3111415

JOANN DEGRAAF

KALKASKA CTY ROD

KALKASKA, MI

RECORDED ON

11/29/2012 1:31 PM

REC FEE: 14.00

PAGES: 1

BK: 3PG: 339

For Corners In:

Kalkaska

(County)

Located In

Corner Code #


1. Public Land Survey	T	26N	R	6W	G8
	T		R		
2. Property Controlling in Section	S	T	R		
	S	T	R		
3. Miscellaneous Property in Section	S	T	R		
	S	T	R		

4. Lot No: Recorded Plat:

5. Private Claims:

I, Joshua R. Davidson, in a field survey on August 6, 2012 do hereby state that under requirements of PA 74, Michigan PA of 1970, the corner points mentioned in lines 1 and 2 above were in conformance with regulations and rules therefore as required in the current manual of survey instructions of the United States Department of the Interior, Bureau of Land Management or by a decree of a Court of Law and/or that the corner points mentioned in lines 3, 4 and 5 above were in conformance with the rules of the Michigan Board of Land Surveyors or by a Decree of a Court of Law; established, re-established, monumented, recovered, found as expressed below:

NOTE: Not more than 2 corners, all in the same town and range, may be recorded on this certificate.

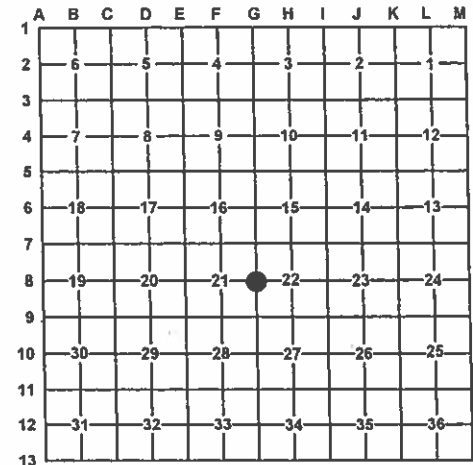

A. Description of original monument and accessories and/or subsequent restoration:

G8 – 1852 – GLO, G. Cannon – Set ¼ post on left bank of stream 50 course SSW

1) Cedar 10" S84½°E 160

B. Description of corner evidence found and/or method applied in restoring or re-establishing corner:

G8 – ¼ corner common to sections 21 & 22, T26N, R6W. Searched river bank for GLO post and cedar bearing tree. No evidence found. I did not use the stream call as stated in the GLO notes, as I believe they would have crossed the river too far South of their corrected position. Set 4" stamped DNR Aluminum cap on 1" X 6' long galvanized iron pipe by single proportion between section corners G7 and G9. Position falls at Southerly bank of river, course S37°E, 1'± South of waters edge. DNR monument accepted as a careful and faithful reestablishment of the position of the original corner.

C. Description of monument for corner and accessories established to perpetuate locating the position of the corner:

G8 – Set 4" stamped DNR Aluminum cap on 1" X 6' long galvanized iron pipe

N0°28'E 225.00' to set 5/8" X 34" rebar on line

S87°27'E 44.00' to set 5/8" X 34" rebar on line

S05°W 23.21' to set ½" rebar

S78°W 16.47' to set ½" rebar

Set blue Carsonite post 1' West



Signed by:

Date:

11-29-2012

Surveyor's Michigan License No.:

46659