



8 0 2 3 2 7 9
Tx:4016447

11/29/2012 1:00:00 PM

LAND CORNER RECORDATION CERTIFICATE

Filing Requirement of Act 74, Mich. PA 1970

For Corners In:

Kalkaska
(County)

Located In

Corner Code #

1. Public Land Survey		T		R	
		T		R	
2. Property Controlling in Section	S 20	T 26N	R 6W		10
	S 20	T 26N	R 6W		15
3. Miscellaneous Property in Section	S	T	R		
	S	T	R		

4. Lot No: _____ Recorded Plat: _____

5. Private Claims: _____


I, Joshua R. Davidson, in a field survey on April 4, 2012 do hereby state that under requirements of PA 74, Michigan PA of 1970, the corner points mentioned in lines 1 and 2 above were in conformance with regulations and rules therefore as required in the current manual of survey instructions of the United States Department of the Interior, Bureau of Land Management or by a decree of a Court of Law and/or that the corner points mentioned in lines 3, 4 and 5 above were in conformance with the rules of the Michigan Board of Land Surveyors or by a Decree of a Court of Law; established, re-established, monumented, recovered, found as expressed below:

NOTE: Not more than 2 corners, all in the same town and range, may be recorded on this certificate.

A. Description of original monument and accessories and/or subsequent restoration:

10 - none

15 - none

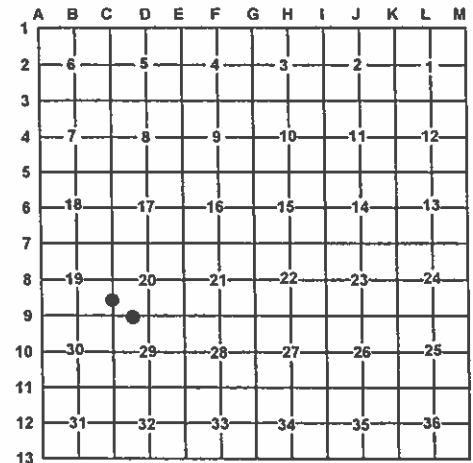

B. Description of corner evidence found and/or method applied in restoring or re-establishing corner:

- 10 - South 1/16 corner common to sections 19 & 20. Set stamped 2" Aluminum cap on 5/8" x 34" rebar per standard BLM procedure, 3'± West of centerline North-South gravel road.
- 15 - West 1/16 corner common to Sections 20 & 29. Found 5/8" threaded bolt in a 3/4" pipe attached to a 1" X 1" square iron bar in centerline old East-West roadbed. Possibly from 1901 W.S. Merrill Highway Survey of Section 20. Added stamped 2" Aluminum cap.

C. Description of monument for corner and accessories established to perpetuate locating the position of the corner:

- 10 - Set a stamped 2" Aluminum Cap on 5/8" x 34" rebar
- N27°E 78.11' to set nail & tag in SE. side 8" Cedar
East 33.00' to set 2" AC
S48°E 53.24' to set nail & tag in NE. side 8" Fir
N34°W 55.19' to set nail & tag in NE. side 7" Elm
Set blue Carsonite post with location tag 33' East
- 15 - Stamped 2" Aluminum Cap on 5/8" threaded bolt in a 3/4" pipe attached to 1" X 1" square iron bar.
- S87°E 18.23' to set nail & tag in N. side 2" Red Maple
S32°E 59.88' to set nail & tag in W. side 16" Red Maple
S50°W 31.48' to set nail & tag in SE. side 3" Red Maple
N48°W 13.35' to set nail & tag in NE. side 13" Cherry
Set blue Carsonite post with location tag 1' Southwest

Signed by:

Joshua R. Davidson
Surveyor's Michigan License No.: 46659

Date:

11-29-2012