

\$7.00  
\$2.00

SURVEY &  
REMONUMENTATION

"other" code #10

FEB 14 1997

LAND CORNER RECORDATION CERTIFICATE  
Filing Requirement of Act 74, Mich. P.A. 1970

For corners in

COMMISSION

KENT COUNTY REMONUMENTATION

Kent  
(County)

Located in: Caledonia  
Township

Corner Code #

1. Public Land Survey T R  
T R  
T R  
T R
2. Property Controlling S 24 T 5N R 10W South Witness  
in Section S T R Monument
3. Miscellaneous S T R 640.0' South of M-7  
Property in Sec. S T R

REG. OF DEEDS

*Lucy Sand*

96 NOV -8 AM 9:25

STATE OF MICHIGAN  
COUNTY OF KENT  
RECEIVED FOR RECORD

9578

Register of Deeds Stamp & File Number

4. Lot No. , Recorded Plat  
5. Private Claims

I, Randy Kolehouse, in a field survey on May 6 19 96,  
do hereby certify that under requirements of P.A. 74 Michigan P.A. of 1970, the corner points mentioned  
in lines 1 and 2 above were in conformance with regulations and rules therefore as required in the  
current manual of survey instructions of the United States Department of the Interior, Bureau of Land  
Management or by a decree of a Court of Law and/or that the corner points mentioned in lines 3, 4 and 5  
above were in conformance with the rules of the Michigan Board of Land Surveyors or by a Decree of a  
Court of Law; established, re-established, monumented, re-monumented, recovered, found as  
expressed below:

NOTE: Not more than 4 corners, all in the same town and range, may be recorded  
on this certificate.

A. Description of original monument and accessories and/or subsequent restoration:

M-7A 1817 G.L.O. Notes L. Lyon  
1992 L.C.R.C. #6551 T. Chettleburgh  
1995 L.C.R.C. #8159 K. Breitels

Corner in Lake - Set Temporary Point  
Set K.C. Monument with Witness Cap  
K.C. Monument

P.A. 345 1990 KENT COUNTY

PEER APPROVED 10/22/96

CHAIRMAN

Peer Group and monumented by T. Chettleburgh

*Harry Rucker*

B. Description of corner evidence found and/or method applied in restoring or reestablishing corner:

M-7A Found a Standard Kent County Monument 1.5' East of the C/L of Dygert Drive and 640.0' South of M-7, T5N, R10W, per  
L.C.R.C.'s #6551 and #8159 as set by T. Chettleburgh on Section line between M-7 and M-8.

L.C.R.C. #6551

L.C.R.C. #8159

KC Remon tag NW side Power Pole N 14° E 65.62'  
KC Remon tag SW side 20" Maple S 40° E 46.81'  
KC Remon tag SW side Power Pole S 20° E 54.93'  
KC Remon tag SE side 12" Elm S 33° W 49.60'  
KC Remon tag NE side 24" Elm N 84° W 28.16'


Nail & KC Remon. tag NW side Power Pole N 14° E 65.65'  
Nail & KC Remon. tag SW side 24" Maple S 40° E 47.30'  
Nail & KC Remon. tag SW side Power Pole S 20° E 54.93'  
Nail & KC Remon. tag NE side 28" Elm N 84° W 28.20'  
Nail & KC Remon. tag SE side Tw. 12" Elm S 30° W 59.25'

The selected location is accepted by me and is generally accepted by professional surveyors as the best available evidence  
of the position of the original corner.

C. Description of monument for corner and accessories established to perpetuate locating the position of the corner:

M-7A Standard Kent County Monument

Nail & K.C. remon. tag on NW side Power pole N 14° E 65.65'  
Nail & K.C. remon. tag on SW side 24" Maple S 40° E 47.30'  
Nail & K.C. remon. tag on SW side Power pole S 20° E 54.93'  
Nail & K.C. remon. tag on NE side 28" Elm N 84° W 28.20'  
Nail & K.C. remon. tag on SE side Tw. 12" Elm S 30° W 59.25'  
K.C. Mon. @ M-8, T5N, R10W, South 2010.3'

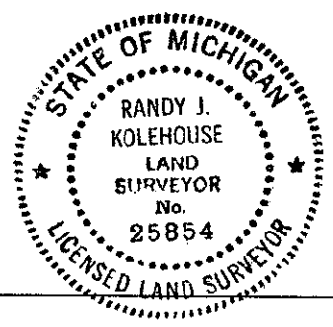

Signed by *Randy J. Kolehouse*  
EARTH TECH

Date 10/8/96

Surveyor's Michigan License No. 25854