

**\$7.00**  
**\$2.00** SEP 18 1995  
**COMMISSION**

**LAND CORNER RECORDATION CERTIFICATE**  
**Filing Requirement of Act 74, Mich. P.A. 1970**  
**KENT COUNTY REMONUMENTATION**

For corners in	Located in:	Corner Code #
Kent (County)		
1. Public Land Survey	T <u>5N</u> R <u>12W</u>	<u>A-3</u>
	T _____ R _____	_____
	T _____ R _____	_____
	T _____ R _____	_____
2. Property Controlling in Section	S _____ T _____ R _____	_____
	S _____ T _____ R _____	_____
3. Miscellaneous Property in Sec.	S _____ T _____ R _____	_____
	S _____ T _____ R _____	_____

STATE OF MICHIGAN  
COUNTY OF KENT  
RECEIVED FOR RECORD


95 AUG 28 AM 10:46

REG. OF DEEDS  
*[Signature]*  
**8546**

Register of Deeds Stamp & File Number

4. Lot No. \_\_\_\_\_, Recorded Plat \_\_\_\_\_
5. Private Claims \_\_\_\_\_

I, Randy Kolehouse, in a field survey on March 13 19 95, do hereby certify that under requirements of P.A. 74 Michigan P.A. of 1970, the corner points mentioned in lines 1 and 2 above were in conformance with regulations and rules therefore as required in the current manual of survey instructions of the United States Department of the interior, Bureau of Land Management or by a decree of a Court of Law and/or that the corner points mentioned in lines 3, 4 and 5 above were in conformance with the rules of the Michigan Board of Land Surveyors or by a Decree of a Court of Law; established, re-established, monumented, re-monumented, recovered, found as expressed below:

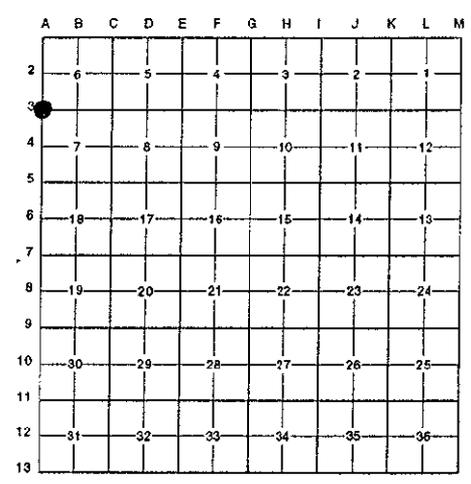

**NOTE: Not more than 4 corners, all in the same town and range, may be recorded on this certificate.**

**A. Description of original monument and accessories and/or subsequent restoration:**

A-3	1817	G.L.O. Notes	L. Lyon	Set Post	P.A. 345 1990 KENT COUNTY
	1961	Wit. Map	K.C. Surveyor	1/2" Iron	PEER APPROVED <u>5/29/99</u>
	1965	Wit. Map	K.C. Surveyor	3/4" Iron	CHAIRMAN <i>[Signature]</i>
	1971	L.C.R.C. #35	Williams & Works	3/4" Iron	
	1981	L.C.R.C. #1550	Nederveld & Jonker	Fnd. 3/4" Iron/Set K.C. Monument	
	1988	L.C.R.C. #4666	Olson, Meyers & May	K.C. Monument	
	1990	L.C.R.C. #5701-A	J. Bueche	K.C. Monument	

This corner was originally approved by the Kent County Remonumentation Peer Group and monumented by Nederveld & Jonker on 1/30/81 and was recorded per L.C.R.C. #1550.

**B. Description of corner evidence found and/or method applied in restoring or reestablishing corner:**

A-3 Found standard Kent County Monument on the C/L of Kenowa Avenue (running N-S) 2' M/L South at the C/L of 68th Street running East as reset by J. Bueche over the top of a K.C. Monument set by Nederveld & Jonker in place of a 3/4" iron on the Town line they found which checked the K.C. Surveyor's records and L.C.R.C. #35.

L.C.R.C. #4666


L.C.R.C. #5701

Nail & Remon tag on W sde P pole S 25° E 101.43'	Pk E side P. pole S 25° E 101.27'
Nail & Remon tag on SE sde 8" twin Ash S 55° W 106.39'	Pk SE side P. pole N 40° E 138.37'
Nail & Remon tag on NW sde P pole N 40° E 138.45'	Nail & remon. tag SE side Twin 8" Ash S 55° W 106.46'
Ottawa County cor. S 28.05'	Nail & remon. tag S side Twin 8" Elm West 78.30'
Nail & tag in S sde twin 8" Elm N 90° W 78.29'	

The selected location is accepted by me and is generally accepted by professional surveyors as the best available evidence of the position of the original corner.

**C. Description of monument for corner and accessories established to perpetuate locating the position of the corner:**

- A-3 Standard Kent County Monument
- PK nail E side P. pole S 25° E 101.35'
  - PK nail SE side P. pole N 40° E 138.90'
  - Nail & K.C. remon. tag SE side Twin 8" Ash S 55° W 106.50'
  - Nail & K.C. remon. tag S side Twin 8" Elm West 78.20'

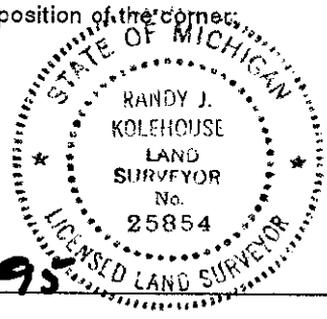

Signed by *Randy J. Kolehouse* Date 8/21/95

Surveyor's Michigan License No. 25854