

~~\$7.00~~ SURVEY & REMONUMENTATION
\$2.00

SEP 18 1995

LAND CORNER RECORDATION CERTIFICATE
Filing Requirement of Act 74, Mich. P.A. 1970
KENT COUNTY REMONUMENTATION

For corners in COMMISSION

Kent (County)	Located in:	Corner Code #
1. Public Land Survey	T <u>5N</u> R <u>12W</u>	<u>A-11</u>
	T <u> </u> R <u> </u>	<u> </u>
	T <u> </u> R <u> </u>	<u> </u>
	T <u> </u> R <u> </u>	<u> </u>
2. Property Controlling in Section	S <u> </u> T <u> </u> R <u> </u>	<u> </u>
	S <u> </u> T <u> </u> R <u> </u>	<u> </u>
3. Miscellaneous Property in Sec.	S <u> </u> T <u> </u> R <u> </u>	<u> </u>
	S <u> </u> T <u> </u> R <u> </u>	<u> </u>

REG. OF DEEDS

8554

Register of Deeds Stamp & File Number

STATE OF MICHIGAN
COUNTY OF KENT
RECEIVED FOR RECORD
95 AUG 28 AM 10:47

4. Lot No. _____, Recorded Plat _____
5. Private Claims _____

I, Randy Kolehouse, in a field survey on March 13 19 95, do hereby certify that under requirements of P.A. 74 Michigan P.A. of 1970, the corner points mentioned in lines 1 and 2 above were in conformance with regulations and rules therefore as required in the current manual of survey instructions of the United States Department of the Interior, Bureau of Land Management or by a decree of a Court of Law and/or that the corner points mentioned in lines 3, 4 and 5 above were in conformance with the rules of the Michigan Board of Land Surveyors or by a Decree of a Court of Law; established, re-established, monumented, re-monumented, recovered, found as expressed below:

NOTE: Not more than 4 corners, all in the same town and range, may be recorded on this certificate.

A. Description of original monument and accessories and/or subsequent restoration:

A-11	1817	G.L.O. Notes	L. Lyon	Set Post	P.A. 345 1990 KENT COUNTY
	1940	Wit. Map	K.C. Surveyor	Monument	PEER APPROVED 5/25/99
	1959	Wit. Map	K.C. Surveyor	Monument Box	CHAIRMAN <u>Randy Kolehouse</u>
	1973	L.C.R.C. #366	Clapp	Steel Bar	
	1981	L.C.R.C. #1557	Nederveld & Jonker	Fnd. Rebar over Steel Bar/Set K.C. Monument	
	1988	L.C.R.C. #4633	Olson, Meyers & May	K.C. Monument	

This corner was originally approved by the Kent County Remonumentation Peer Group and monumented by Nederveld & Jonker on 1/26/81 and was recorded per L.C.R.C. #1557.

B. Description of corner evidence found and/or method applied in restoring or reestablishing corner:

- A-11 Found standard Kent County Monument (10" below grade) 3' M/L East of C/L of Kenowa Avenue running N-S on C/L of 100th Street running East per L.C.R.C.'s #1557 and #4633 as set by Nederveld & Jonker in place of a rebar over a steel bar they found which checked with L.C.R.C. #366 and also K.C. Surveyor's records.

L.C.R.C. #1557

L.C.R.C. #4633

Nail & Remon. tag on W side 18" Maple NE 39.33'
Nail & Remon. tag on NE side 10" Elm NW 37.45'
Nail & Remon. tag on NW side 40" Maple SW 37.37'
Ottawa County corner S 60.59'


Nail & Remon tag on W side 20" Maple N 30° E 39.33'
Nail & Remon tag on NE side 12" Elm N 50° W 37.45'
Nail & Remon tag on NW side 42" Maple SW 37.37'
Ottawa County cor S 60.59'

The selected location is accepted by me and is generally accepted by professional surveyors as the best available evidence of the position of the original corner.

C. Description of monument for corner and accessories established to perpetuate locating the position of the corner:

- A-11 Standard Kent County Monument

Nail & K.C. remon. tag in 36" Maple Southwest 37.18'
Nail & K.C. remon. tag in 18" Maple Northeast 39.49'
Nail & K.C. remon. tag in W side 20" Maple N 30° E 39.33'
Nail & K.C. remon. tag in NE side 12" Elm N 50° W 37.45'
Nail & K.C. remon. tag in NW side 42" Maple S 52° W 37.85'
Ottawa County corner South 60.59'

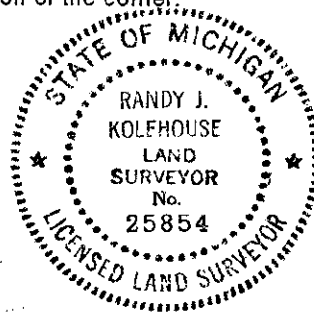

Signed by Randy J. Kolehouse

Date

8/21/95

Surveyor's Michigan License No. 25854