

Surveyor  
REMONUMENTATION

\$7.00  
\$2.00 SEP 13 1995

LAND CORNER RECORDATION CERTIFICATE  
Filing Requirement of Act 74, Mich. P.A. 1970  
KENT COUNTY REMONUMENTATION

For corners in

Kent (County)	Located in:	Corner Code #
1. Public Land Survey	T <u>5N</u> R <u>12W</u>	<u>C-4</u>
	T _____ R _____	_____
	T _____ R _____	_____
	T _____ R _____	_____
2. Property Controlling in Section	S _____ T _____ R _____	_____
	S _____ T _____ R _____	_____
3. Miscellaneous Property in Sec.	S _____ T _____ R _____	_____
	S _____ T _____ R _____	_____

STATE OF MICHIGAN  
COUNTY OF KENT  
RECEIVED FOR RECORD  
95 AUG 28 AM 10:48  
REG. OF DEEDS  
8567  
Register of Deeds Stamp & File Number

4. Lot No. \_\_\_\_\_, Recorded Plat \_\_\_\_\_  
5. Private Claims \_\_\_\_\_

I, Randy Kolehouse, in a field survey on March 15 19 95,  
do hereby certify that under requirements of P.A. 74 Michigan P.A. of 1970, the corner points  
mentioned in lines 1 and 2 above were in conformance with regulations and rules therefore as required  
in the current manual of survey instructions of the United States Department of the interior, Bureau of  
Land Management or by a decree of a Court of Law and/or that the corner points mentioned in lines 3,  
4 and 5 above were in conformance with the rules of the Michigan Board of Land Surveyors or by a  
Decree of a Court of Law; established, re-established, monumented, re-monumented, recovered,  
found as expressed below:

NOTE: Not more than 4 corners, all in the same town and range, may be recorded  
on this certificate.

A. Description of original monument and accessories and/or subsequent restoration:

C-4	1831	G.L.O. Notes	Mullett	Set Post
	1954	Wit. Map	K.C. Surveyor	1/2" Iron Over Stone
	1954	Wit. Map	K.C. Surveyor	Iron in Monument Box
	1972	L.C.R.C. #151	Medema, Van Kooten & Assoc.	3/4" Iron
	1981	L.C.R.C. #1566	Nederveld & Jonker	End. 3/4" Iron/Set K.C. Monument
	1988	L.C.R.C. #4677	Olson, Meyers & May	K.C. Monument

P.A. 345 1990 KENT COUNTY  
PEER APPROVED 5/25/95  
CHAIRMAN Randy Kolehouse

This corner was originally approved by the Kent County Remonumentation Peer Group and monumented by Nederveld & Jonker on 1/12/81 and was recorded per L.C.R.C. #1566.

B. Description of corner evidence found and/or method applied in restoring or reestablishing corner:

C-4 Found standard Kent County Monument 2' ± East of C/L of Wilson Avenue running N-S per L.C.R.C.'s #1566 and #4677 as  
set by Nederveld & Jonker in place of a 3/4" iron they found which checked L.C.R.C. #151 and also checks one remaining  
witness from the K.C. Surveyor's records.

L.C.R.C. #1566

L.C.R.C. #4677


Iron W 33.03'	Iron N 90 33.03'
Nail & Remon. tag on S side P. pole NW 38.56'	Nail & Remon tag on S sde P pole N 55 W 38.56'
Nail & Remon. tag on N side Basswood clump W 67.28'	Nail & Remon tag on N sde Basswood clump N 85 W 67.28'

The selected location is accepted by me and is generally accepted by professional surveyors as the best available evidence  
of the position of the original corner.

C. Description of monument for corner and accessories established to perpetuate locating the position of the corner:

C-4 Standard Kent County Monument

Iron West 33.03'  
Nail & K.C. remon. tag on S side P. pole N 55° W 38.66'  
Nail & K.C. remon. tag on N side Basswood clump N 85° W 67.28'  
NW cor. garage fndn. S 87° E 144.18'  
NW cor. hse. fndn. S 45° E 110.62'  
C/L blacktop West 2' M/L

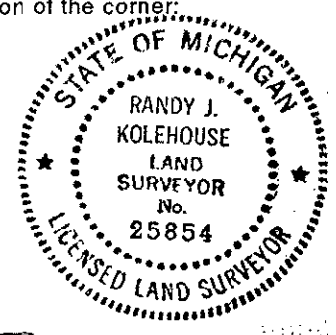

Signed by Randy J. Kolehouse Date 8/21/95  
EARTH TECH

Surveyor's Michigan License No. 25854