

**SURVEY &  
REMONUMENTATION**

APR 27 1995

**LAND CORNER RECORDATION CERTIFICATE**  
Filing Requirement of Act 74, Mich. P.A. 1970

STATE OF MICHIGAN  
COUNTY OF KENT  
RECEIVED FOR RECORD

94 DEC 28 PM 2: 15

For corners in **COMMISSION**  
Kent  
(County)

Located In:

Corner Code #

- |                                    |   |    |   |     |      |
|------------------------------------|---|----|---|-----|------|
| 1. Public Land Survey              | T | 5N | R | 12W | D-12 |
|                                    | T |    | R |     |      |
|                                    | T |    | R |     |      |
|                                    | T |    | R |     |      |
| 2. Property Controlling in Section | S |    | T | R   |      |
|                                    | S |    | T | R   |      |
| 3. Miscellaneous Property in Sec.  | S |    | T | R   |      |
|                                    | S |    | T | R   |      |

REG. OF DEEDS

7913

Register of Deeds Stamp & File Number

4. Lot No. \_\_\_\_\_, Recorded Plat \_\_\_\_\_  
5. Private Claims \_\_\_\_\_

I, Douglas W. Bonnema in a field survey on Nov. 19, 1994, do hereby certify that under requirements of P.A. 74, Michigan P.A. of 1970, the corner points mentioned in lines 1 and 2 above were in conformance with regulations and rules therefore as required in the current manual of survey instructions of the United States Department of the Interior, Bureau of Land Management or by a decree of a Court of Law and/or that the corner points mentioned in lines 3, 4 and 5 above were in conformance with the rules of the Michigan Board of Land Surveyors or by a Decree of a Court of Law; established, re-established, monumented, re-monumented, recovered, found as expressed below:

**NOTE: Not more than 4 corners, all in the same town and range, may be recorded on this certificate.**

	A	B	C	D	E	F	G	H	I	J	K	L	M
2	6	5	4	3	2	1							
3													
4	7	8	9	10	11	12							
5													
6	18	17	16	15	14	13							
7													
8	19	20	21	22	23	24							
9													
10	30	29	28	27	26	25							
11													
12	31		33	34	35	36							
13													

A. Description of original monument and accessories and/or subsequent restoration:

Since this is not a government corner there is no G.L.O. information.

Williams & Works 1895 stone  
K.C. Road Commission 1961 iron & stone  
Face of 14" W. Cherry NW 56.40'  
Face of 24" Maple N-NW 166.7'  
Face of 30" Maple N-NE 153.5'

Exxel Engineering, Nederveld and Williams & Works are all presently holding the iron as the center of Section.

P.A. 345 1990 KENT COUNTY

PEER APPROVED 10/12/94

CHAIRMAN Harry Hubers

B. Description of corner evidence found and/or method applied in restoring or reestablishing corner:


Found 3/4" x 16" iron pipe  
Center of 16" W. Cherry N19°W 56.88'  
Center of 48" Maple N11°E 155.07'

Williams & Works determined the iron is 6.5' North and 2.6' East of the intersection of the 1/4 lines.

The selected location is accepted by me and is generally accepted by professional surveyors as the best available evidence of the position of the corner.

C. Description of monument for corner and accessories established to perpetuate locating the position of the corner:

Replaced iron with 4" x 30" Kent County Cast Iron Mon.	
Nail & KC tag in SW sde 16" Walnut	S22°E 65.06'
Nail & KC tag in S'ly sde new P.Pole	S73°E 48.65'
Nail & KC tag in S'ly sde 12" Walnut	N89°E 39.63'
Nail & KC tag in SE sde 12" Walnut	N63°E 34.35'
Nail & KC tag in W'ly sde 48" Maple	N11°E 155.07'
Nail & KC tag in E'ly sde tw 16" W. Cherry	N19°W 56.88'
Nail & KC tag in N'ly sde 14" Maple	N69°W 64.90'
Nail & KC tag in N'ly sde	N81°W 28.04'
Center of N-S Blacktop	West 0.5'

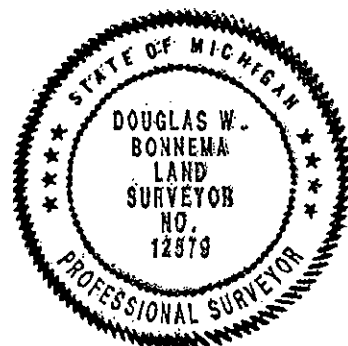

Signed by Douglas W. Bonnema  
Surveyor's Michigan License No. 12579

Date 12/14/94