

Survey &  
REMONUMENTATION  
\$7.00  
\$2.00 SEP 18 1995

LAND CORNER RECORDATION CERTIFICATE  
Filing Requirement of Act 74, Mich. P.A. 1970  
KENT COUNTY REMONUMENTATION

COMMISSION

For corners in

Kent (County)	Located in:	Corner Code #
1. Public Land Survey	T <u>5N</u> R <u>12W</u>	<u>E-3</u>
	T _____ R _____	_____
	T _____ R _____	_____
	T _____ R _____	_____
2. Property Controlling in Section	S _____ T _____ R _____	_____
	S _____ T _____ R _____	_____
3. Miscellaneous Property in Sec.	S _____ T _____ R _____	_____
	S _____ T _____ R _____	_____

STATE OF MICHIGAN  
COUNTY OF KENT  
RECEIVED FOR RECORD  
95 AUG 28 AM 10:49  
REG. OF DEEDS  
8586

Register of Deeds Stamp & File Number

4. Lot No. \_\_\_\_\_, Recorded Plat \_\_\_\_\_  
5. Private Claims \_\_\_\_\_

I, Randy Kolehouse, in a field survey on April 13 19 95, do hereby certify that under requirements of P.A. 74 Michigan P.A. of 1970, the corner points mentioned in lines 1 and 2 above were in conformance with regulations and rules therefore as required in the current manual of survey instructions of the United States Department of the interior, Bureau of Land Management or by a decree of a Court of Law and/or that the corner points mentioned in lines 3, 4 and 5 above were in conformance with the rules of the Michigan Board of Land Surveyors or by a Decree of a Court of Law; established, re-established, monumented, re-monumented, recovered, found as expressed below:

NOTE: Not more than 4 corners, all in the same town and range, may be recorded on this certificate.

A. Description of original monument and accessories and/or subsequent restoration:

E-3	1831	G.L.O. Notes	Mullett	Set Post
	1940	Wit. Map	K.C. Surveyor	Concrete Monument
	??	Wit. Map	K.C. Surveyor	1" Iron in Mon. Box
	1972	L.C.R.C. #167	Medema, Van Kooten & Assoc.	1" Iron in Mon. Box
	1972	L.C.R.C. #195	Spicer	1" Iron in Mon. Box
	1981	L.C.R.C. #1578	Nederveld & Jonker	Replaced 1" Iron w/Standard K.C. Mon. in Mon. Box
	1988	L.C.R.C. #4655	Olson, Meyers & May	K.C. Monument

P.A. 345 1900 KENT COUNTY

PEER APPROVED 8/25/95

CHAIRMAN Randy Kolehouse

This corner was originally approved by the Kent County Remonumentation Peer Group and monumented by Nederveld & Jonker on 2/4/81 and was recorded per L.C.R.C. #1578.

B. Description of corner evidence found and/or method applied in restoring or reestablishing corner:

E-3 Found standard Kent County Monument in monument box 2' South of C/L of 68th Street running E-W and 4' West of C/L Ivanrest running N-S as set by Nederveld & Jonker in place of a 1" iron which checked L.C.R.C.'s #167 and #195.

L.C.R.C. #1578

L.C.R.C. #4655

Nail & Remon. tag on N. side P. pole WSW 85.55'  
NW cor. hse. found SE 80.55'

Nail & K.C. Remon tag on N sde P pole S 75 W 85.55'  
NW cor hse fndn S 45 E 80.55'

Nail & K.C. Remon tag in W sde L pole S 35 W 34.31'

Nail & K.C. Remon tag in S sde twin 16" Cherry S 75 E 34.77'

The selected location is accepted by me and is generally accepted by professional surveyors as the best available evidence of the position of the original corner.

C. Description of monument for corner and accessories established to perpetuate locating the position of the corner:


E-3 Standard Kent County Monument in a Monument Box

Nail & K.C. remon. tag on N. side P. pole S 75° W 85.55'

NW cor. hse. fndn. S 45° E 80.55'

Nail & K.C. remon. tag on W side L. pole S 35° W 34.31'

Nail & K.C. remon. tag on S side Twin 16" Cherry S 75° E 34.77'

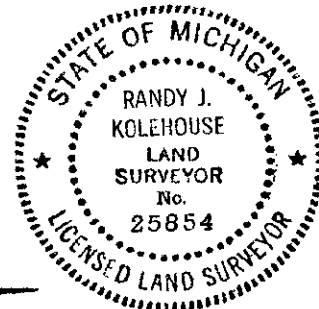

Signed by

Randy J. Kolehouse  
EARTH TECH

Date

8/21/95

Surveyor's Michigan License No.

25854