

\$7.00  
\$2.00

JAN 23 1996

COMMISSION

LAND CORNER RECORDATION CERTIFICATE  
Filing Requirement of Act 74, Mich. P.A. 1970  
KENT COUNTY REMONUMENTATION

Seq. 2

For corners in

Kent  
(County)

Located in:

Corner Code #

1. Public Land Survey T 5N R 12W H-6  
T \_\_\_\_\_ R \_\_\_\_\_  
T \_\_\_\_\_ R \_\_\_\_\_  
T \_\_\_\_\_ R \_\_\_\_\_  
2. Property Controlling S \_\_\_\_\_ T \_\_\_\_\_ R \_\_\_\_\_  
in Section S \_\_\_\_\_ T \_\_\_\_\_ R \_\_\_\_\_  
3. Miscellaneous S \_\_\_\_\_ T \_\_\_\_\_ R \_\_\_\_\_  
Property in Sec. S \_\_\_\_\_ T \_\_\_\_\_ R \_\_\_\_\_

4. Lot No. \_\_\_\_\_, Recorded Plat \_\_\_\_\_  
5. Private Claims \_\_\_\_\_

STATE OF MICHIGAN  
COUNTY OF KENT  
RECEIVED FOR RECORD  
95 DEC 28 PM 2:18  
REG. OF DEEDS  
8889  
Register of Deeds Stamp & File Number

I, Randy Kolehhouse, in a field survey on April 20 19 95,  
do hereby certify that under requirements of P.A. 74 Michigan P.A. of 1970, the corner points  
mentioned in lines 1 and 2 above were in conformance with regulations and rules therefore as required  
in the current manual of survey instructions of the United States Department of the Interior, Bureau of  
Land Management or by a decree of a Court of Law and/or that the corner points mentioned in lines 3,  
4 and 5 above were in conformance with the rules of the Michigan Board of Land Surveyors or by a  
Decree of a Court of Law; established, re-established, monumented, re-monumented, recovered,  
found as expressed below:

NOTE: Not more than 4 corners, all in the same town and range, may be recorded  
on this certificate.

A. Description of original monument and accessories and/or subsequent restoration:

H-6 This corner was not originally set by the G.L.O.

1966	Wit. Map	K.C. Surveyor	Stone	P.A. 345 1990 KENT COUNTY
1974	L.C.R.C. #765	Exxel Engineering	Found Stone	PEER APPROVED <u>8/24/95</u>
1992	L.C.R.C. #6654	Chris Marschall	Found Stone/Set K.C. Monument	CHAIRMAN <u>Harry Phibbs</u>

A	B	C	D	E	F	G	H	I	J	K	L	M
2	6	5	4	3	2	1						
3												
4	7	8	9	10	11	12						
5												
6	18	17	16	15	14	13						
7												
8	19	20	21	22	23	24						
9												
10	30	29	28	27	26	25						
11												
12	31	32	33	34	35	36						
13												

B. Description of corner evidence found and/or method applied in restoring or reestablishing corner:

H-6 Found K.C. Monument in tree rows running N-S and West per L.C.R.C.'s #765 and #6654 as set by Chris Marschall in place  
of stone they found which checks L.C.R.C. #765 and K.C. Surveyor's witness map - 1966. Kent County Monument is 2.1'  
South and 0.8' East of the Intersection of 1/4 lines. Accepted Kent County as Center Section.


L.C.R.C. #6654

- Nail and Tag SW sd. 16" W. Cherry N 16° W 18.90'  
Nail and Tag N. sd. 6" Maple N 73° W 31.96'  
Nail and Tag NW sd. 20" W. Cherry S 36° W 9.49'  
Nail and Tag SE sd. 48" Beech 57.42'

C. Description of monument for corner and accessories established to perpetuate locating the position of the corner:

H-6 Standard Kent County Monument

- Nail & K.C. remon. tag in SW side 16" W. Cherry N 16° W 18.90'  
Nail & K.C. remon. tag in N side 6" Maple N 73° W 31.96'  
Nail & K.C. remon. tag in NW side 20" Cherry S 36° W 9.49'  
Nail & K.C. remon. tag in SE side 48" Beech N 63° E 57.42'

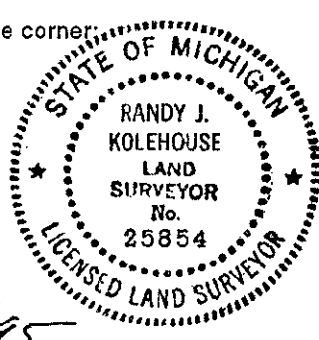

Signed by Randy J. Kolehhouse Date 12/22/95  
EARTH TECH

Surveyor's Michigan License No. 25854