

SEP 1 9 1995
\$7.00
\$2.00
COMMISSION

LAND CORNER RECORDATION CERTIFICATE
Filing Requirement of Act 74, Mich. P.A. 1970
KENT COUNTY REMONUMENTATION

For corners in

Kent (County)	Located in:	Corner Code #
1. Public Land Survey	T <u>5N</u> R <u>12W</u>	<u>H-9</u>
	T _____ R _____	_____
	T _____ R _____	_____
	T _____ R _____	_____
2. Property Controlling in Section	S _____ T _____ R _____	_____
	S _____ T _____ R _____	_____
3. Miscellaneous Property in Sec.	S _____ T _____ R _____	_____
	S _____ T _____ R _____	_____

STATE OF MICHIGAN
COUNTY OF KENT
RECEIVED FOR RECORD
95 AUG 28 AM 10:52
8621

Register of Deeds Stamp & File Number

4. Lot No. _____, Recorded Plat _____
5. Private Claims _____

I, Randy Kolehhouse, in a field survey on April 7 19 95,
do hereby certify that under requirements of P.A. 74 Michigan P.A. of 1970, the corner points
mentioned in lines 1 and 2 above were in conformance with regulations and rules therefore as required
in the current manual of survey instructions of the United States Department of the interior, Bureau of
Land Management or by a decree of a Court of Law and/or that the corner points mentioned in lines 3,
4 and 5 above were in conformance with the rules of the Michigan Board of Land Surveyors or by a
Decree of a Court of Law; established, re-established, monumented, re-monumented, recovered,
found as expressed below:

NOTE: Not more than 4 corners, all in the same town and range, may be recorded
on this certificate.

A. Description of original monument and accessories and/or subsequent restoration:

H-9	1831	G.L.O. Notes	Mullett	Set Post
	1963	Wit. Map	K.C. Surveyor	1/2" Iron
	1978	L.C.R.C. #1201	Nederveld & Jonker	Found 1" Iron
	1979	L.C.R.C. #1294	Exxel Engineering	Found 1/2" Iron
	1980	L.C.R.C. #2301	Nederveld & Jonker	Found 3/4" Iron/Set K.C. Monument

P.A. 345 1980 KENT COUNTY
PEER APPROVED 5/25/95

CHAIRMAN Randy J. Kolehhouse

This corner was originally approved by the Kent County Remonumentation Peer Group and monumented by Nederveld & Jonker on 9/3/81 and was recorded per L.C.R.C. #2301.

B. Description of corner evidence found and/or method applied in restoring or reestablishing corner:

H-9 Found standard Kent County Monument 2' North of C/L of 92nd Street running E-W and on C/L Celery Avenue running South
per L.C.R.C.'s #1294, #2301 and #6323 as set by Nederveld & Jonker in place of a 3/4" iron they found which checked
L.C.R.C. #1201.

L.C.R.C. #2301

L.C.R.C. #6323

Nail & K.C. Remon. tag SE side T. pole S60°W 50.09'
Nail & K.C. Remon. tag S side 4" ash N75°W 100.45'


Nail & Tag SE sd. UP S 60 W 50.16'
Nail & Tag W sd. 8" Elm S 36 W 51.86'
Nail & Tag S sd. 12" Ash N 75 W 100.40'

The selected location is accepted by me and is generally accepted by professional surveyors as the best available evidence
of the position of the original corner.

C. Description of monument for corner and accessories established to perpetuate locating the position of the corner:

H-9 Standard Kent County Monument

Nail & K.C. remon. tag on SE side Util. pole S 60° W 50.16'
Nail & K.C. remon. tag on W side 8" Elm S 36° W 51.86'
Nail & K.C. remon. tag on S side 12" Ash N 75° W 100.40'

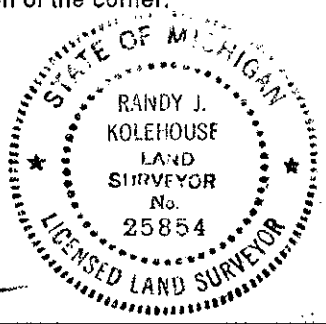

Signed by Randy J. Kolehhouse
EARTH TECH

Date 8/21/95

Surveyor's Michigan License No. 25854