

LAND CORNER RECORDATION CERTIFICATE
Filing Requirement of Act 74, Mich. P.A. 1970
KENT COUNTY REMONUMENTATION

For corners in

Kent
(County)

Located in:

Corner Code #

- | | | | |
|------------------------------------|-------------|--------------|------------|
| 1. Public Land Survey | T <u>5N</u> | R <u>12W</u> | <u>K-3</u> |
| | T | R | |
| | T | R | |
| | T | R | |
| 2. Property Controlling in Section | S | T | R |
| | S | T | R |
| 3. Miscellaneous Property in Sec. | S | T | R |
| | S | T | R |

4. Lot No. _____, Recorded Plat _____
5. Private Claims _____

I, Randy Kolehouse, in a field survey on April 5 19 95, do hereby certify that under requirements of P.A. 74 Michigan P.A. of 1970, the corner points mentioned in lines 1 and 2 above were in conformance with regulations and rules therefore as required in the current manual of survey instructions of the United States Department of the Interior, Bureau of Land Management or by a decree of a Court of Law and/or that the corner points mentioned in lines 3, 4 and 5 above were in conformance with the rules of the Michigan Board of Land Surveyors or by a Decree of a Court of Law; established, re-established, monumented, re-monumented, recovered, found as expressed below:

NOTE: Not more than 4 corners, all in the same town and range, may be recorded on this certificate.

A. Description of original monument and accessories and/or subsequent restoration:

K-3	1831	G.L.O. Notes	Mullett	Set Post
	N/A	Wit. Map	K.C. Surveyor	1 1/2" Iron on Leaded Stone
	1978	L.C.R.C. #1162	Exxel Engineering	Found 1/2" Iron
	1980	L.C.R.C. #1538	Exxel Engineering	Found 1/2" Iron/Set K.C. Monument
	1987	L.C.R.C. #4527	J. Bueche	K.C. Monument
	1991	L.C.R.C. #6345	Chris Marschall	K.C. Monument

This corner was originally approved by the Kent County Remonumentation Peer Group and monumented by Exxel Engineering on 12/10/80 and was recorded per L.C.R.C. #1538

B. Description of corner evidence found and/or method applied in restoring or reestablishing corner:

K-3 Found standard Kent County Monument at the C/L intersection of Clyde Park running N-S and 68th Street running E-W per L.C.R.C.'s #1538, #4527 and #6345 as set by Exxel Engineering in place of a 1/2" iron they found which checked L.C.R.C. #1162.

L.C.R.C. #4527

L.C.R.C. #6345

Nail & tag in SE side 26" Ash (3.5' above ground)
S 57° W 93.73'

Nail & Tag SW sd. U.P. N 30 W 68.73'
SW cor. brick front Hse. #784 (1' above ground) S 37 E 137.43'
NW cor. brick Hse #784 (1' above ground) S 40 E 120.06'
Nail & Tag SE sd. 28" Ash S 57 W 93.59'

The selected location is accepted by me and is generally accepted by professional surveyors as the best available evidence of the position of the original corner.

C. Description of monument for corner and accessories established to perpetuate locating the position of the corner:

K-3 Standard Kent County Monument

SW cor. brick front hse. #784 (1' above ground) S 37° E 137.43'
NW cor. brick hse. #784 (1' above ground) S 40° E 120.06'
Nail & K.C. remon. tag on SW side Util. pole N 30° W 68.73'
Nail & K.C. remon. tag on SE side 28" Ash S 57° W 93.59'
Nail & K.C. remon. tag on NW side P. pole N 55° E 64.92'

Signed by Randy J Kolehouse
EARTH TECH

Date

8/21/95

Surveyor's Michigan License No. 25854


REG. OF DEEDS

8646

Register of Deeds Stamp & File Number

95 AUG 28 AM 10:53

STATE OF MICHIGAN
COUNTY OF KENT
RECEIVED FOR RECORD

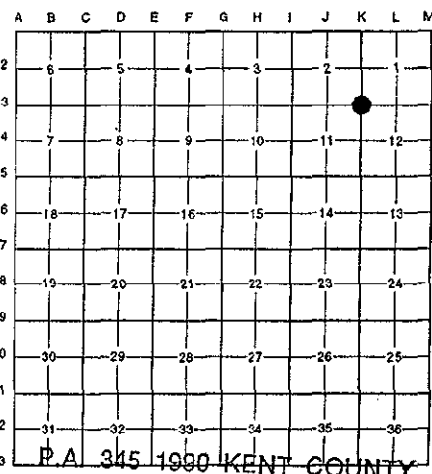

PEER APPROVED 8/24/95
CHAIRMAN Randy J Kolehouse

